
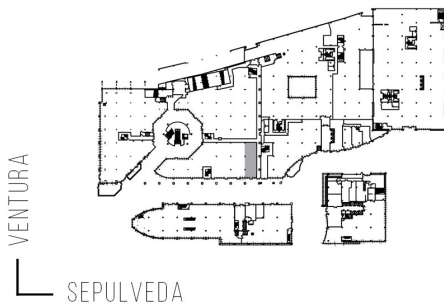


15301  
VENTURA

SOG-RETAIL BUILDING

SUITE P13 | 2,077 RSF

SHERMAN OAKS/ENCINO

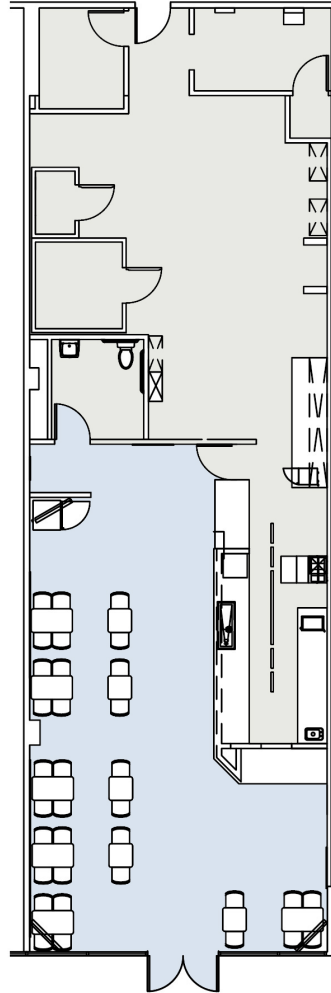

AS-BUILT CONFIGURATION

NOT TO SCALE  
FURNITURE NOT INCLUDED

For more information, please contact:

310.255.7777  
leasing@douglasemmett.com

**Douglas  
Emmett**