
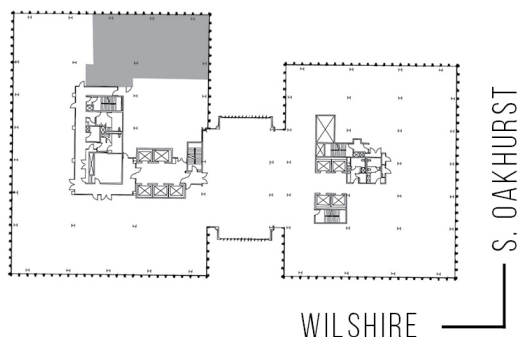


9100 WILSHIRE

9100 WILSHIRE EAST TOWER

SUITE 620 | 3,570 RSF

BEVERLY HILLS

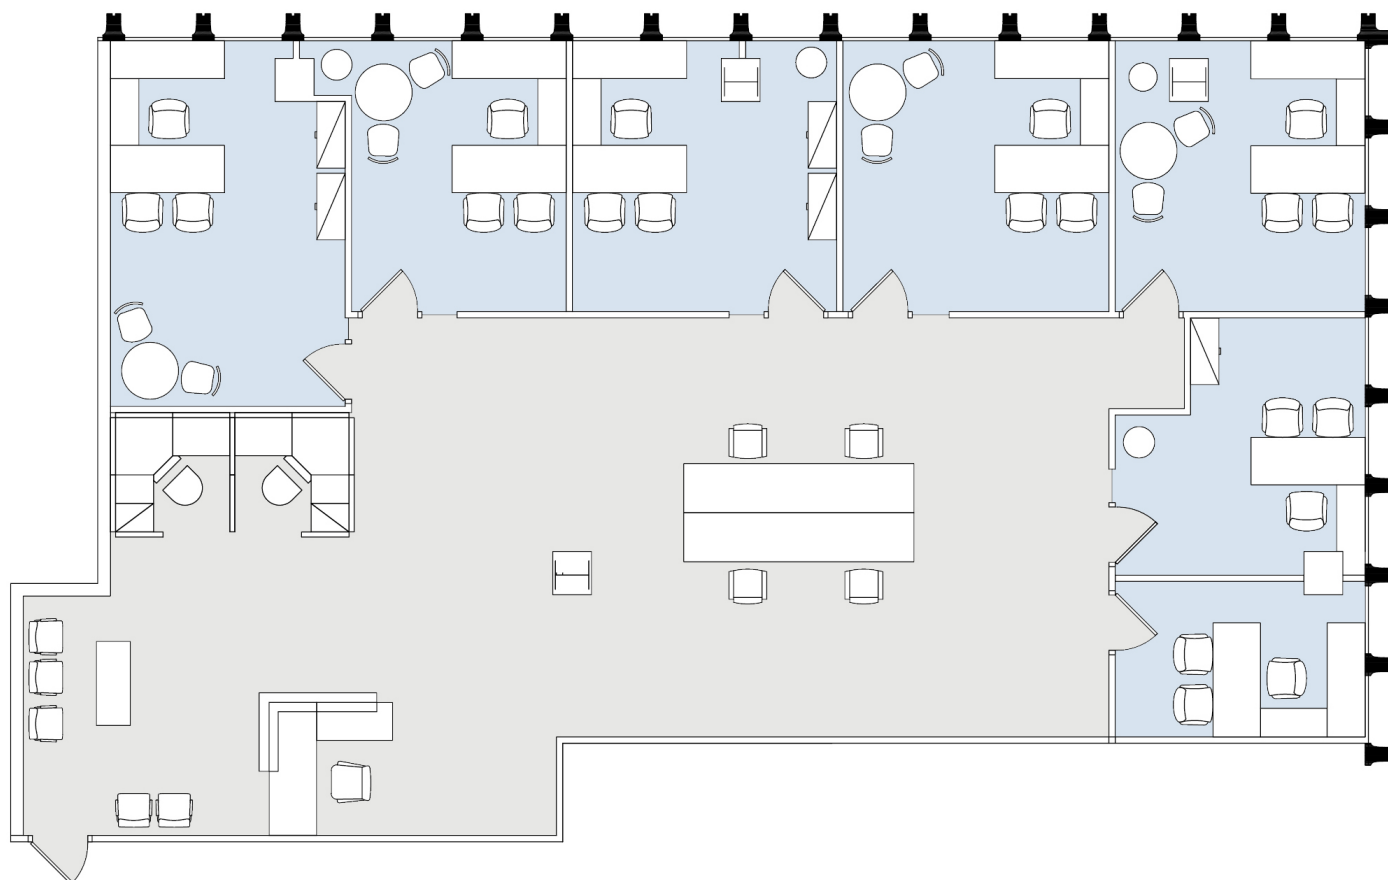

AS-BUILT CONFIGURATION

OFFICES:	7
RECEPTION:	1

NOT TO SCALE
FURNITURE NOT INCLUDED

For more information, please contact:

310.255.7777

leasing@douglasemmett.com

**Douglas
Emmett**