
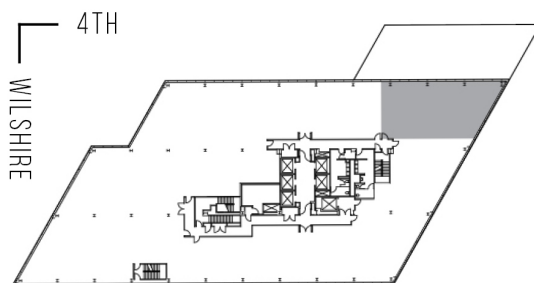


401 WILSHIRE

SUITE 230 | 2,422 RSF

SANTA MONICA

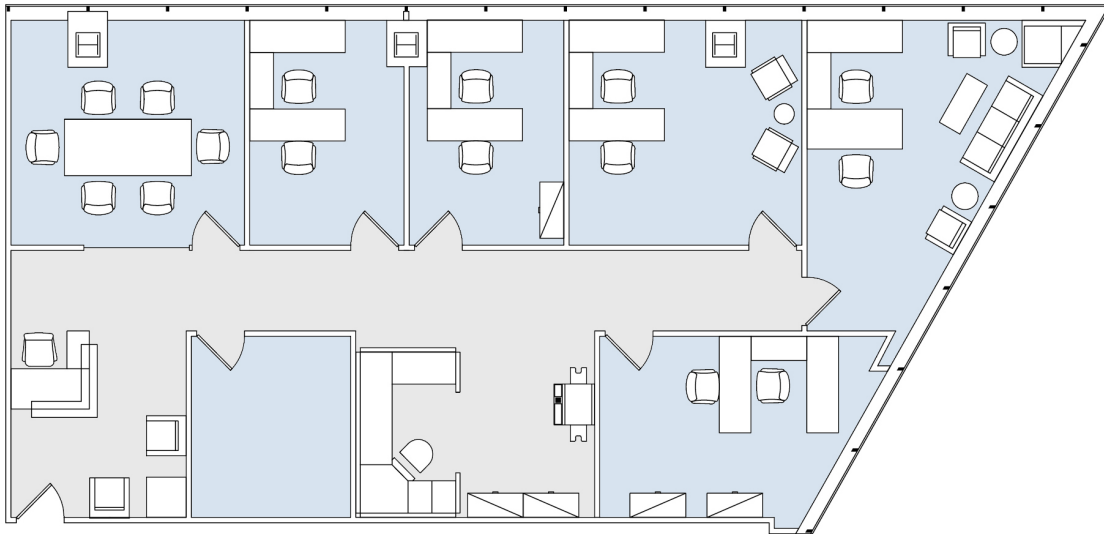

AS-BUILT CONFIGURATION

| | |
|------------------|---|
| OFFICES: | 5 |
| CONFERENCE ROOM: | 1 |
| RECEPTION: | 1 |
| STORAGE ROOM: | 1 |

NOT TO SCALE
FURNITURE NOT INCLUDED

For more information, please contact:

310.255.7777
leasing@douglasemmett.com

**Douglas
Emmett**