
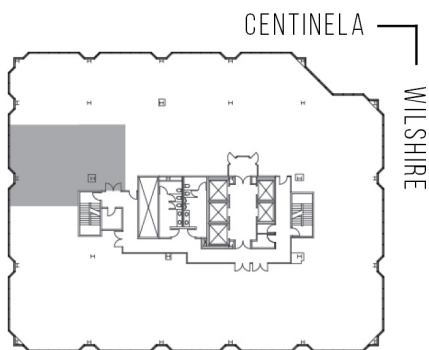


12424 WILSHIRE

GATEWAY LOS ANGELES

SUITE 850 | 1,713 RSF

BRENTWOOD-WILSHIRE

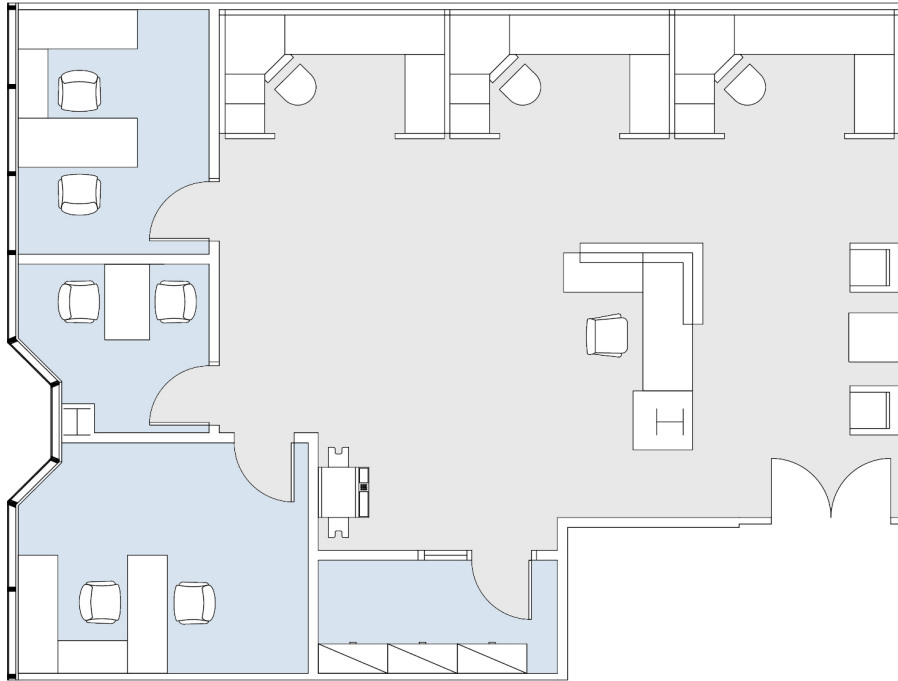

AS-BUILT CONFIGURATION

OFFICES:	3
RECEPTION AREA:	1
I.T. / FILE ROOM:	1

ADJUSTED FOR SOCIAL DISTANCING

NOT TO SCALE

FURNITURE NOT INCLUDED

For more information, please contact:

310.255.7777
leasing@douglasemmett.com

**Douglas
Emmett**