
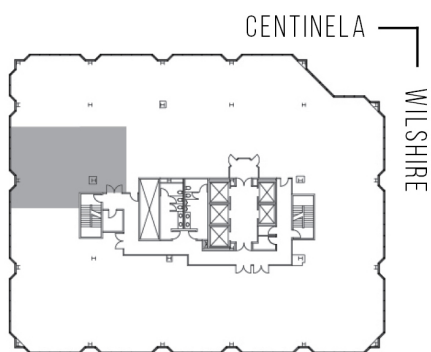


12424 WILSHIRE

GATEWAY LOS ANGELES

SUITE 850 | 1,713 RSF

BRENTWOOD-WILSHIRE

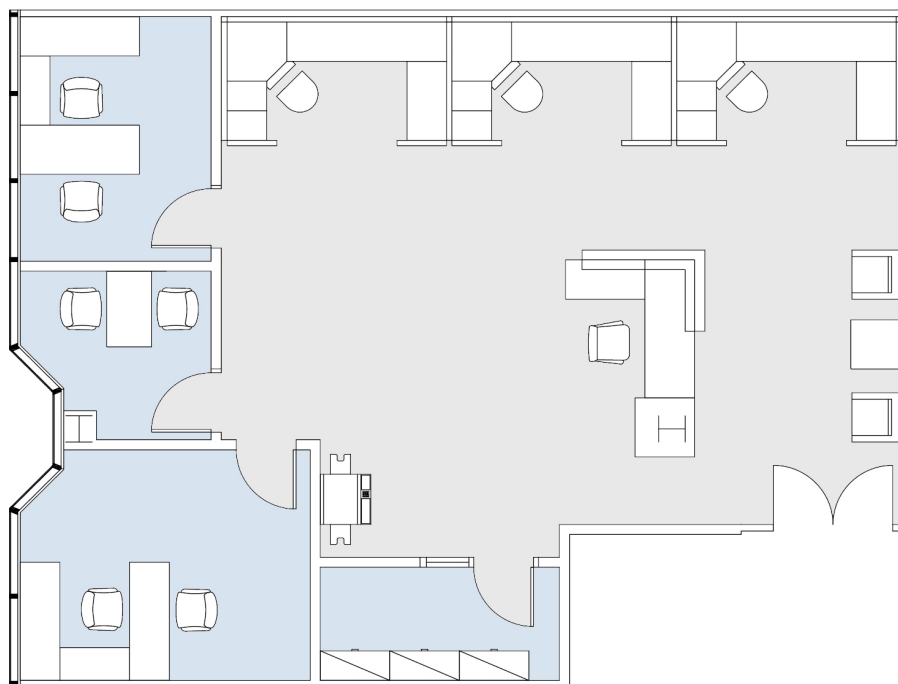

AS-BUILT CONFIGURATION

| | |
|-------------------|---|
| OFFICES: | 3 |
| RECEPTION AREA: | 1 |
| I.T. / FILE ROOM: | 1 |

ADJUSTED FOR SOCIAL DISTANCING
NOT TO SCALE
FURNITURE NOT INCLUDED

For more information, please contact:

310.255.7777
leasing@douglasemmett.com

**Douglas
Emmett**