
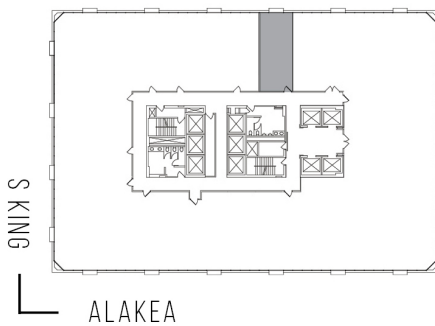


1001 BISHOP STREET

BISHOP SQUARE - ASB TOWER

SUITE 987 | 550 RSF

HONOLULU

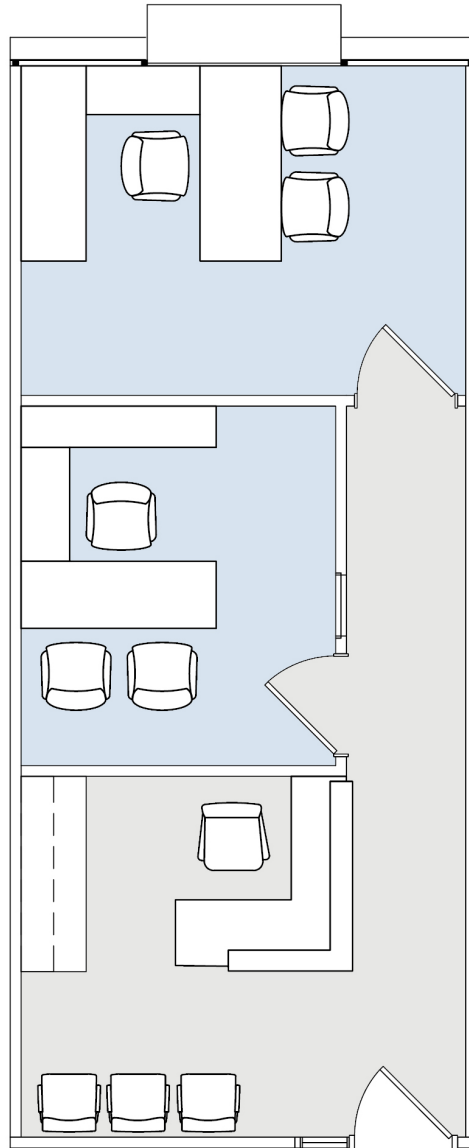

AS-BUILT CONFIGURATION

OFFICES: 2

RECEPTION AREA: 1

NOT TO SCALE
FURNITURE NOT INCLUDED

For more information, please contact:

310.255.7777

leasing@douglasemmett.com

**Douglas
Emmett**