



21600

WARNER CENTER TOWER - I

SUITE 1100 | 5,766 RSF

WOODLAND HILLS

OXNARD STREET

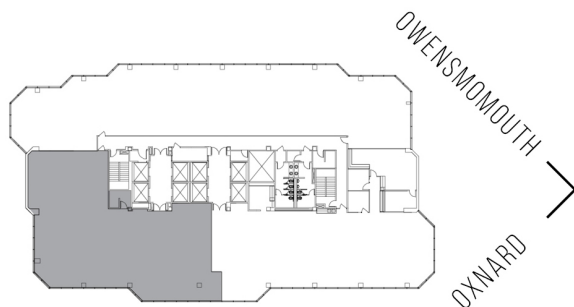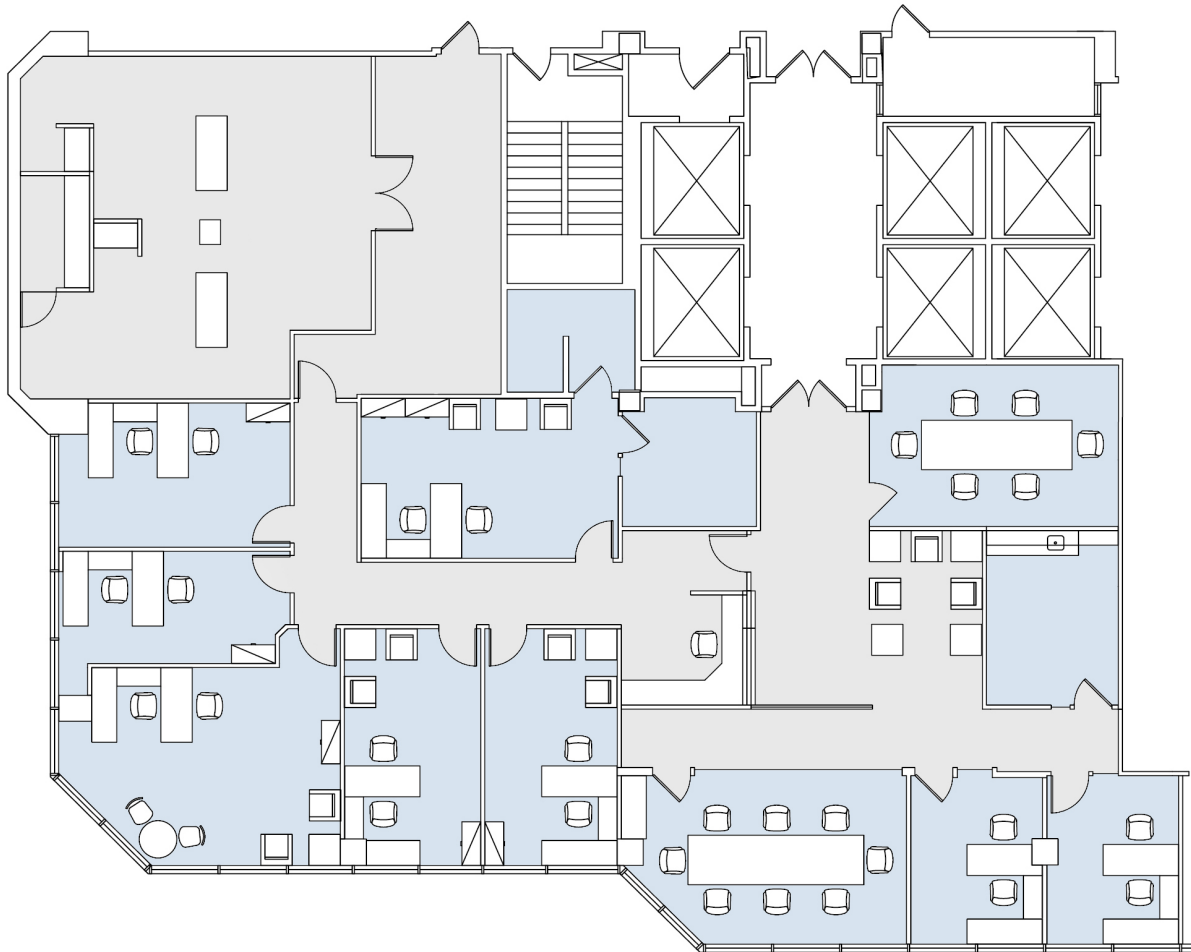

AS-BUILT CONFIGURATION

OFFICES:	8
CONFERENCE ROOMS:	2
RECEPTION AREA:	1
KITCHEN:	1
I.T. ROOM:	1
STORAGE ROOM:	1
MOCK COURT ROOM:	1

ADJUSTED FOR SOCIAL DISTANCING
NOT TO SCALE
FURNITURE NOT INCLUDED

For more information, please contact:

310.255.7777
leasing@douglasemmett.com

**Douglas
Emmett**