
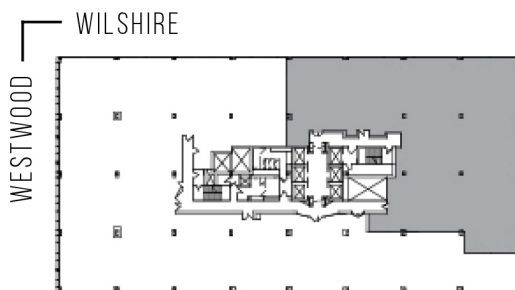


10880 WILSHIRE

SUITE 2070 | 9,631 RSF

WESTWOOD

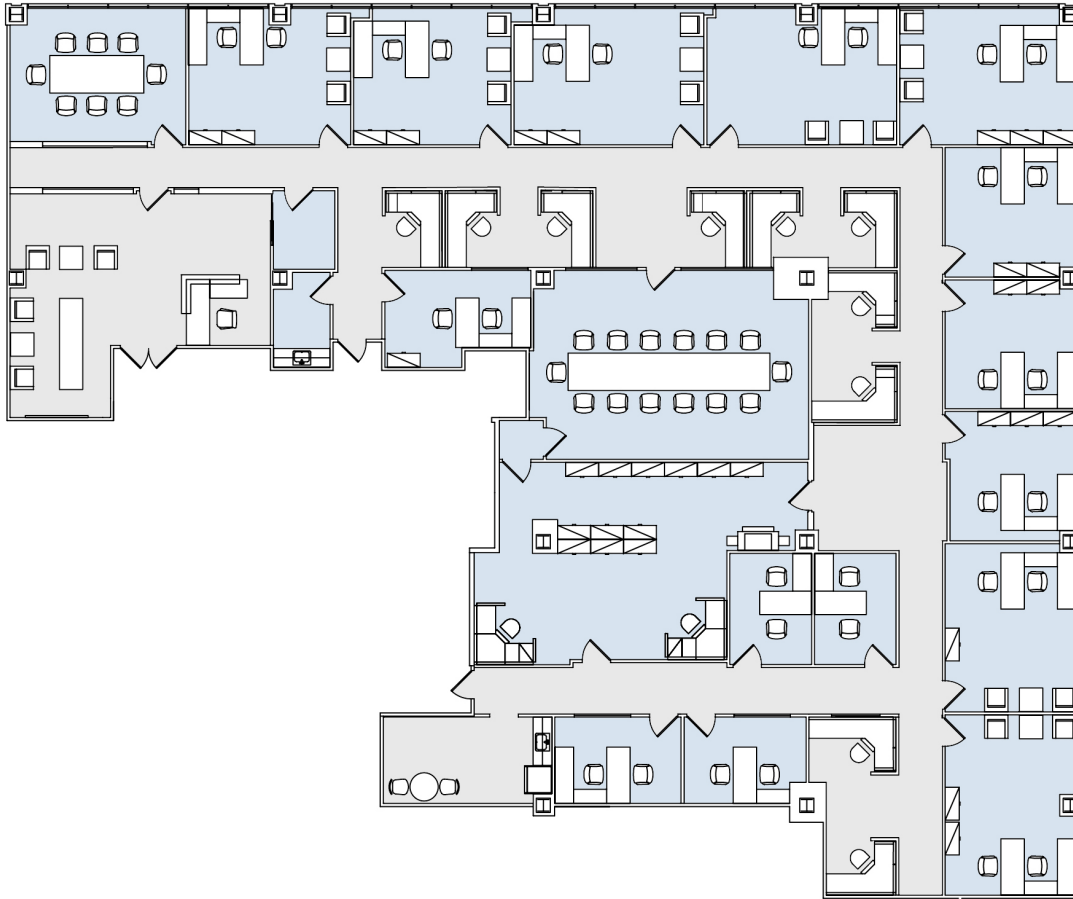

AS-BUILT CONFIGURATION

OFFICES:	15
CONFERENCE ROOMS:	2
RECEPTION AREA:	1
KITCHENS:	2
COPY/FILE ROOM:	1
I.T. ROOM:	1

ADJUSTED FOR SOCIAL DISTANCING
NOT TO SCALE
FURNITURE NOT INCLUDED

For more information, please contact:

310.255.7777

leasing@douglasemmett.com

**Douglas
Emmett**