
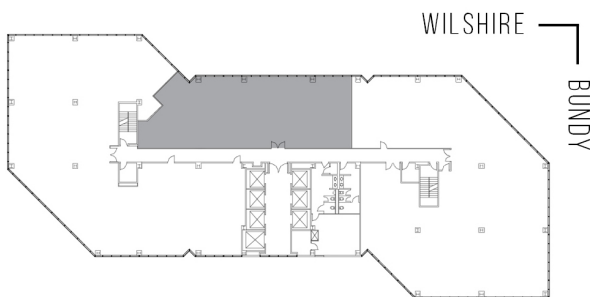


12100 WILSHIRE

SUITE 720 | 3,459 RSF

BRENTWOOD-WILSHIRE

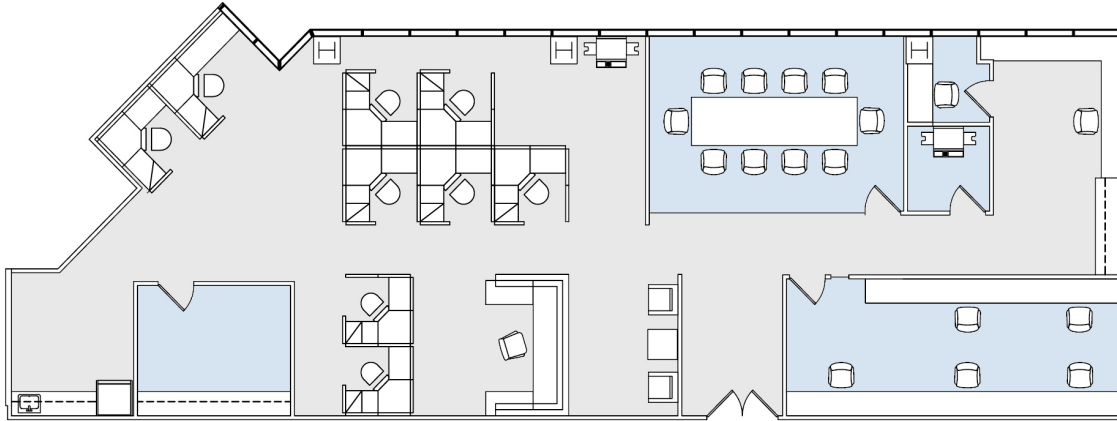

AS-BUILT CONFIGURATION

| | |
|-----------------------|---|
| OFFICES: | 1 |
| CONFERENCE ROOM: | 1 |
| RECEPTION: | 1 |
| COPY ROOM: | 1 |
| KITCHEN: | 1 |
| WORK ROOM: | 1 |
| STORAGE/ SERVER ROOM: | 1 |

ADJUSTED FOR SOCIAL DISTANCING
NOT TO SCALE
FURNITURE NOT INCLUDED

For more information, please contact:

310.255.7777
leasing@douglasemmett.com

**Douglas
Emmett**