
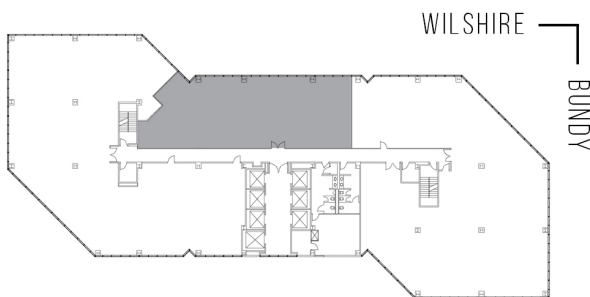


12100 WILSHIRE

SUITE 720 | 3,459 RSF
BRENTWOOD-WILSHIRE

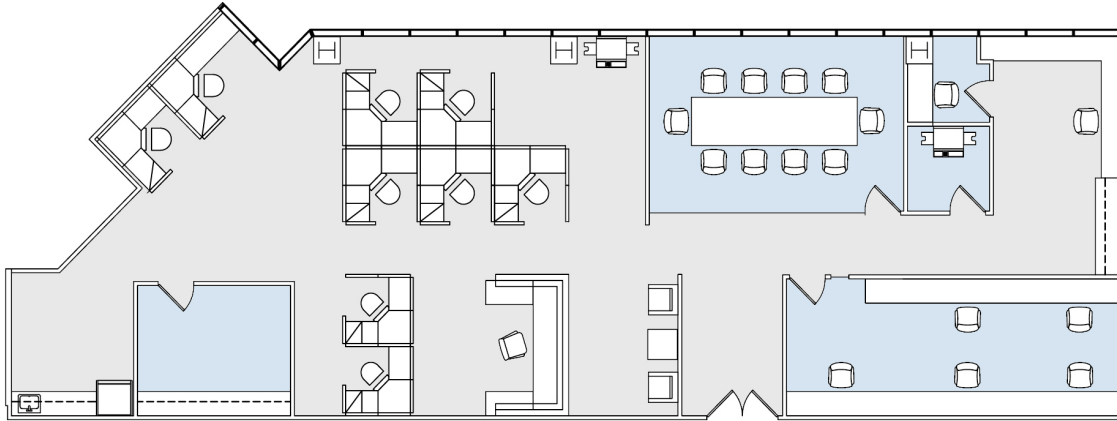

AS-BUILT CONFIGURATION

OFFICES:	1
CONFERENCE ROOM:	1
RECEPTION:	1
COPY ROOM:	1
KITCHEN:	1
WORK ROOM:	1
STORAGE/ SERVER ROOM:	1

ADJUSTED FOR SOCIAL DISTANCING
NOT TO SCALE
FURNITURE NOT INCLUDED

For more information, please contact:

310.255.7777

leasing@douglasemmett.com

**Douglas
Emmett**