


# 10880 WILSHIRE

SUITE 900 | 6,555 RSF

WESTWOOD

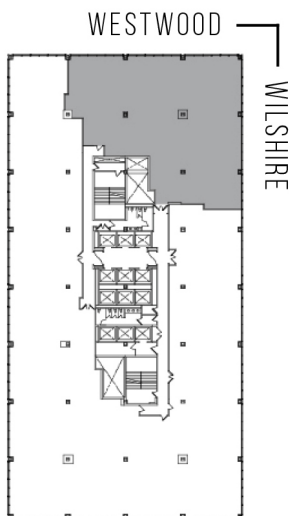

#### AS-BUILT CONFIGURATION

OFFICES:	15
CONFERENCE ROOM:	1
RECEPTION:	1
KITCHEN:	1
I.T./ STORAGE ROOM:	1

ADJUSTED FOR SOCIAL DISTANCING

NOT TO SCALE  
FURNITURE NOT INCLUDED

For more information, please contact:

310.255.7777  
leasing@douglasemmett.com

**Douglas  
Emmett**