



11726

BRENTWOOD EXECUTIVE PLAZA

SUITE 240 | 2,641 RSF

SAN VICENTE

BRENTWOOD-SAN VICENTE

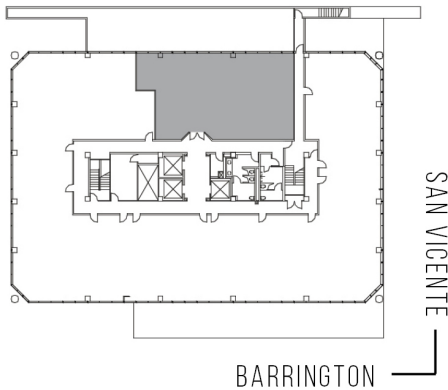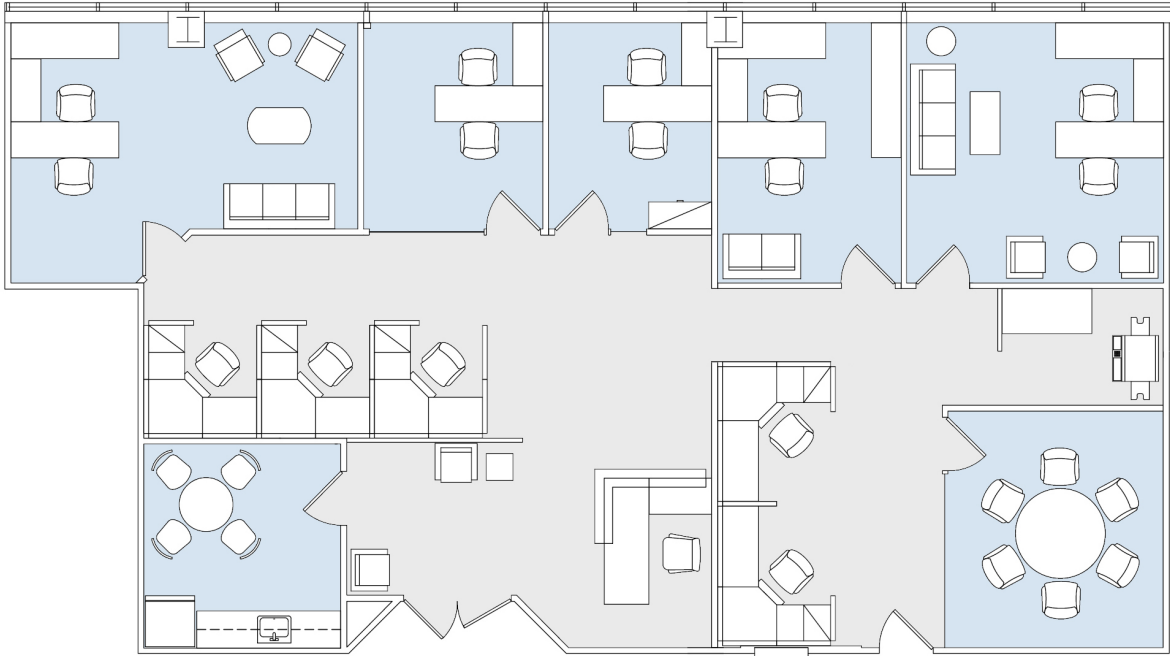

AS-BUILT CONFIGURATION

OFFICES:	5
CONFERENCE ROOM:	1
RECEPTION AREA:	1
KITCHEN:	1

ADJUSTED FOR SOCIAL DISTANCING
NOT TO SCALE
FURNITURE NOT INCLUDED

For more information, please contact:

310.255.7777

leasing@douglasemmett.com

**Douglas
Emmett**