
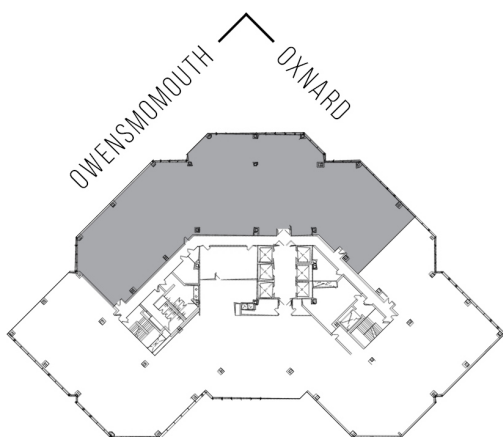


21650 OXNARD STREET

WARNER CENTER TOWER - III

SUITE 1730 | 9,534 RSF

WOODLAND HILLS

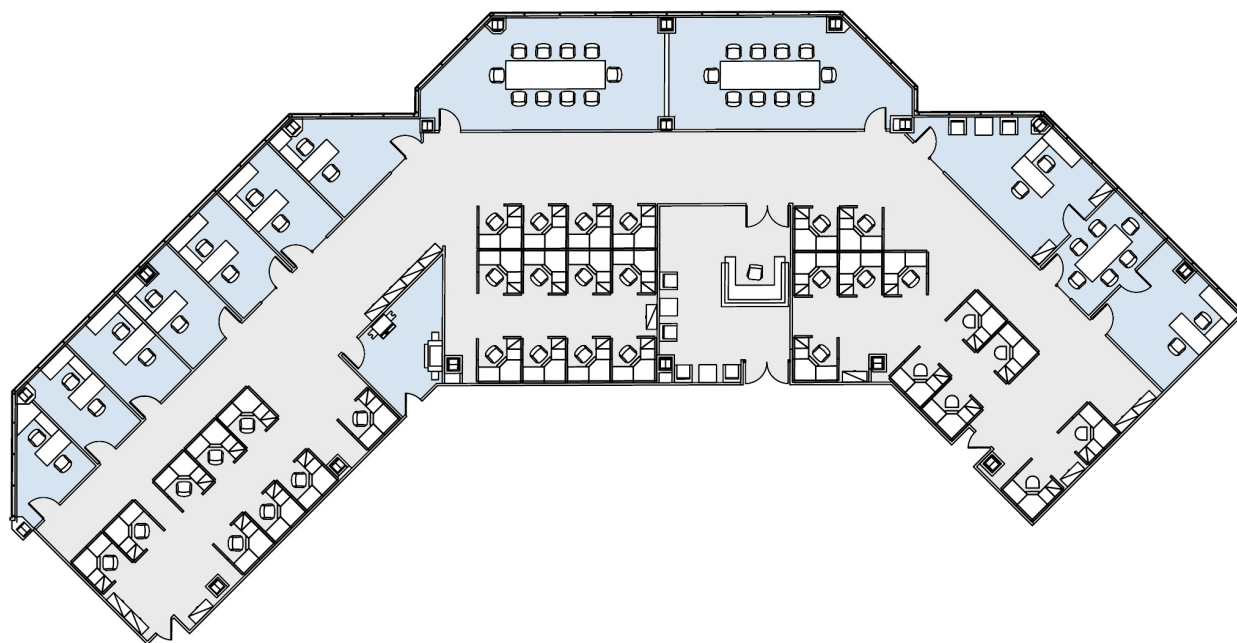

AS-BUILT CONFIGURATION

OFFICES:	9
CONFERENCE ROOMS:	3
RECEPTION:	1
COPY ROOM:	1

ADJUSTED FOR SOCIAL DISTANCING
NOT TO SCALE
FURNITURE NOT INCLUDED

For more information, please contact:

310.255.7777

leasing@douglasemmett.com

**Douglas
Emmett**