



21650

WARNER CENTER TOWER - III

SUITE 1730 | 9,534 RSF

WOODLAND HILLS

OXNARD STREET

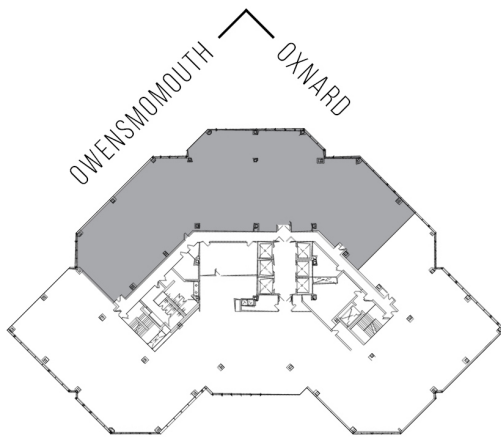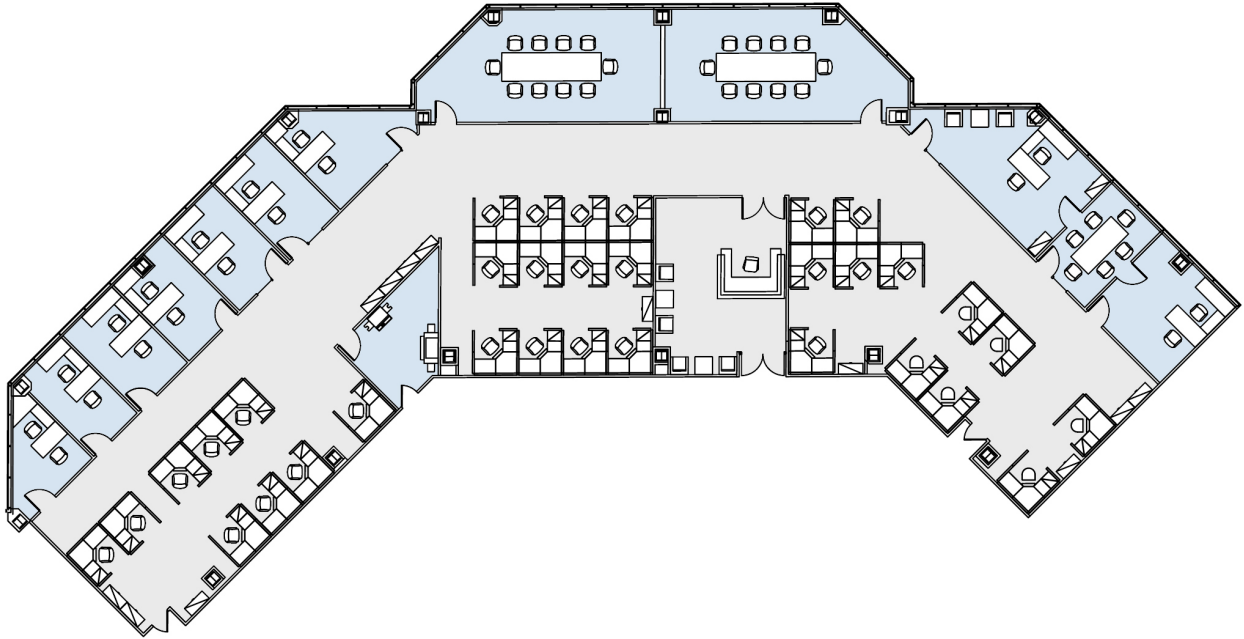

AS-BUILT CONFIGURATION

| | |
|-------------------|---|
| OFFICES: | 9 |
| CONFERENCE ROOMS: | 3 |
| RECEPTION: | 1 |
| COPY ROOM: | 1 |

ADJUSTED FOR SOCIAL DISTANCING
NOT TO SCALE
FURNITURE NOT INCLUDED

For more information, please contact:

310.255.7777
leasing@douglasemmett.com

**Douglas
Emmett**