
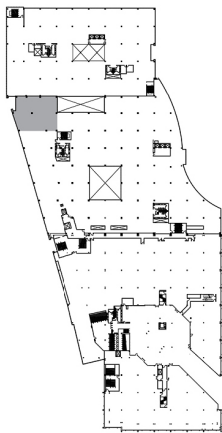


15301
VENTURA

SOG-COURTYARD BUILDING

SUITE 310 | 6,461 RSF

SHERMAN OAKS/ENCINO

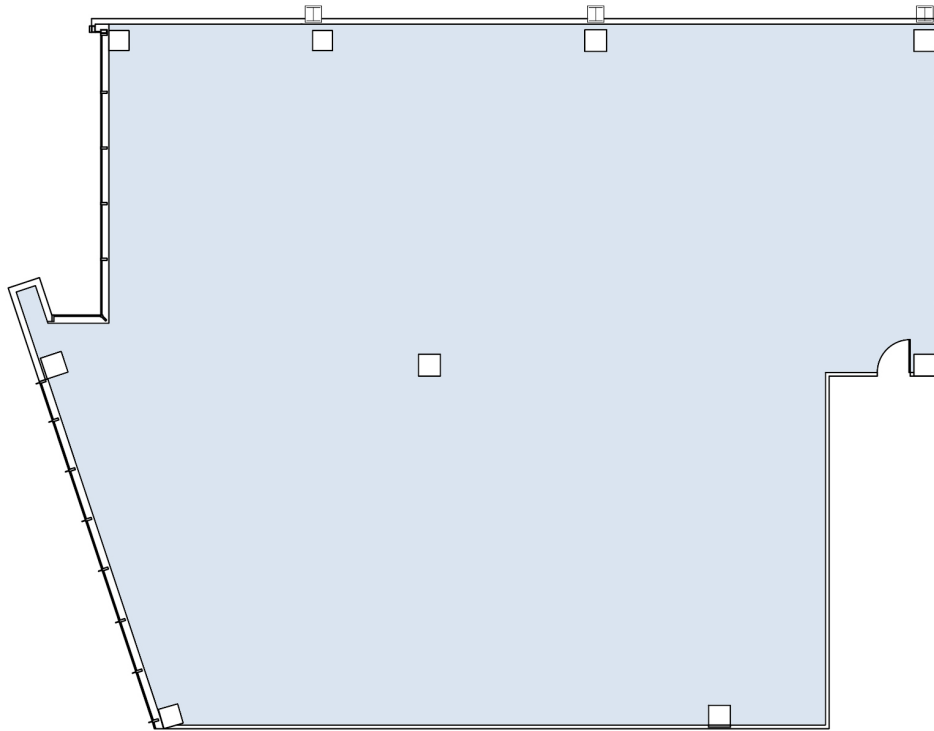

SEPULVEDA
VENTURA

AS-BUILT CONFIGURATION

OPEN SPACE

NOT TO SCALE
FURNITURE NOT INCLUDED

For more information, please contact:

310.255.7777

leasing@douglasemmett.com

**Douglas
Emmett**