
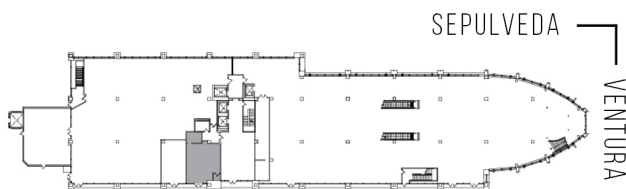


15301 VENTURA

SOG-RETAIL BUILDING

SUITE P20 | 721 RSF

SHERMAN OAKS/ENCINO

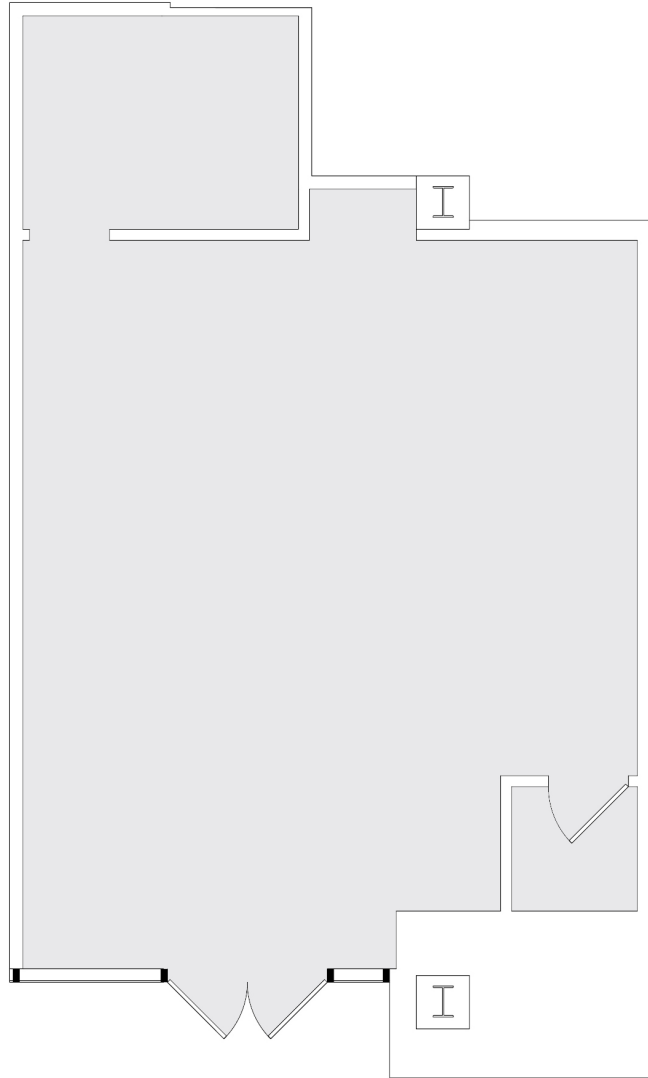

AS-BUILT CONFIGURATION

NOT TO SCALE
FURNITURE NOT INCLUDED

For more information, please contact:

310.255.7777

leasing@douglasemmett.com

**Douglas
Emmett**