
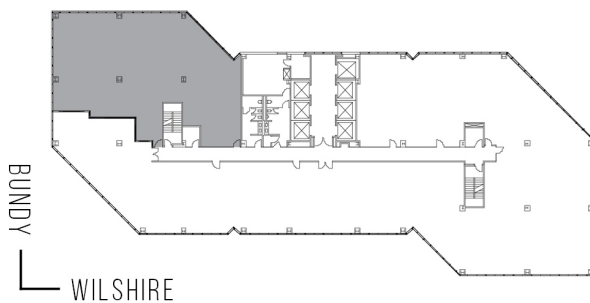


12100 WILSHIRE

SUITE 600 | 4,809 RSF

BRENTWOOD-WILSHIRE

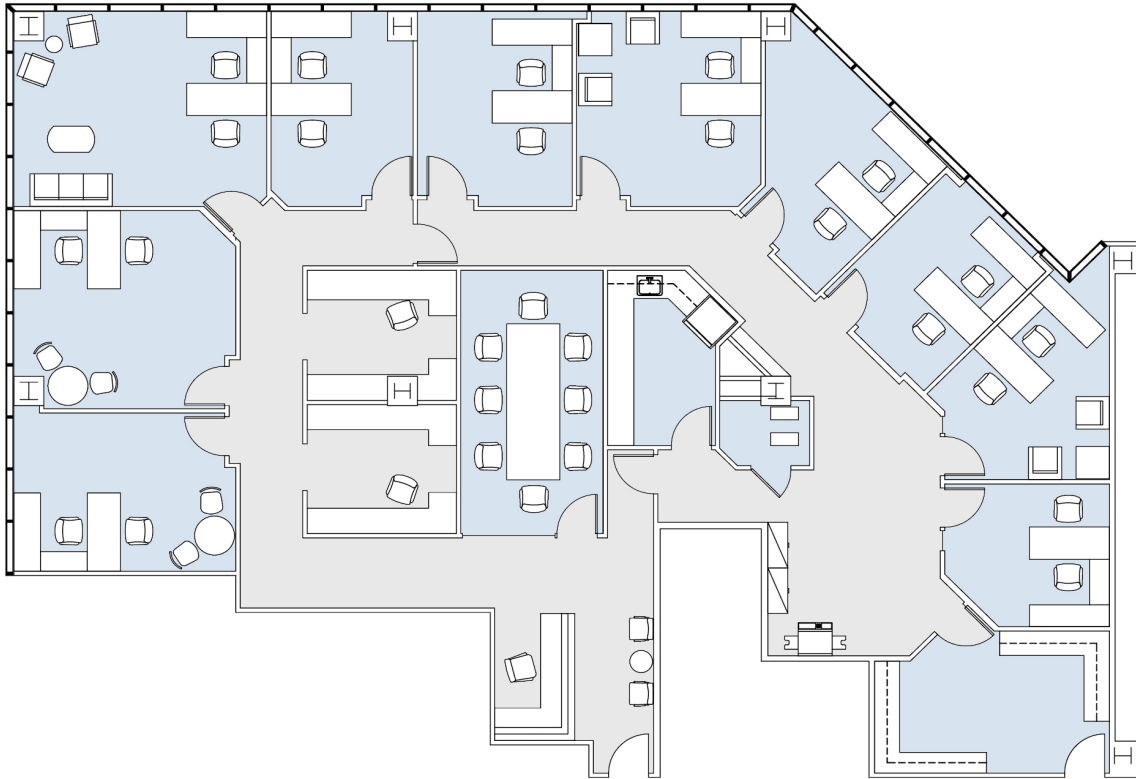

AS-BUILT CONFIGURATION

OFFICES:	10
CONFERENCE ROOM:	1
RECEPTION:	1
KITCHEN:	1
STORAGE ROOM:	1
I.T. ROOM:	1

ADJUSTED FOR SOCIAL DISTANCING
NOT TO SCALE
FURNITURE NOT INCLUDED

For more information, please contact:

310.255.7777
leasing@douglasemmett.com

**Douglas
Emmett**