
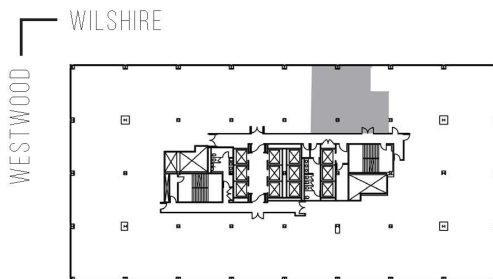


# 10880 WILSHIRE

SUITE 915 | 1,655 RSF  
WESTWOOD

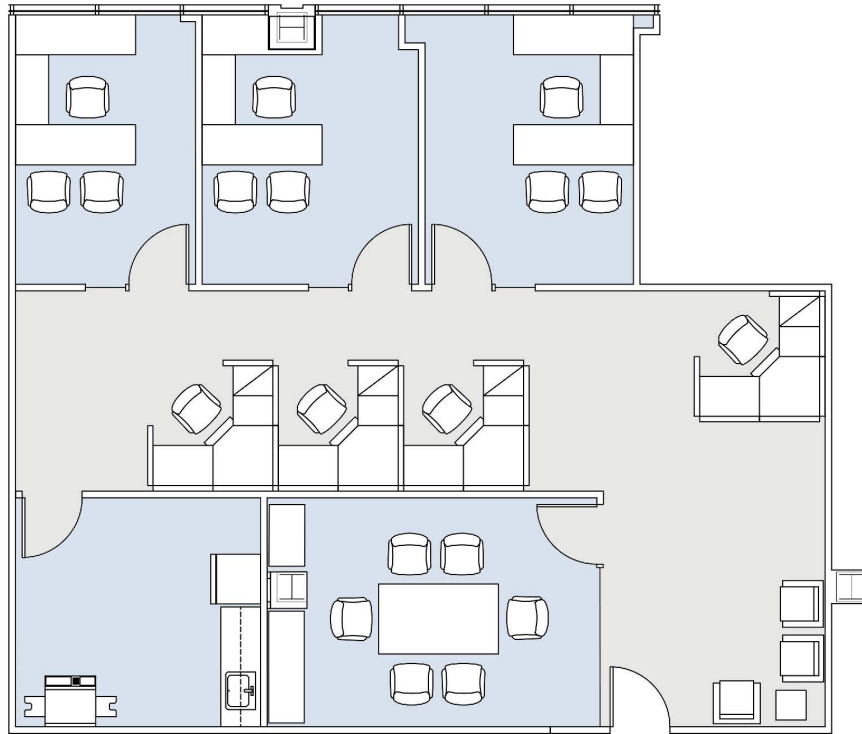

#### AS-BUILT CONFIGURATION

OFFICES:	3
WORKSTATIONS:	4
CONFERENCE ROOM:	1
KITCHEN:	1

NOT TO SCALE  
FURNITURE NOT INCLUDED

For more information, please contact:

310.255.7777  
leasing@douglasemmett.com

**Douglas  
Emmett**