
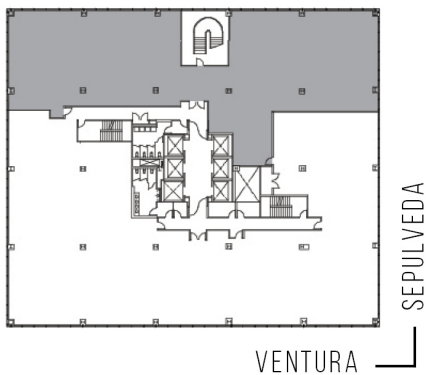


# 15303 VENTURA

SOG-COMERICA BANK BUILDING

SUITE 450 | 8,314 RSF

SHERMAN OAKS/ENCINO

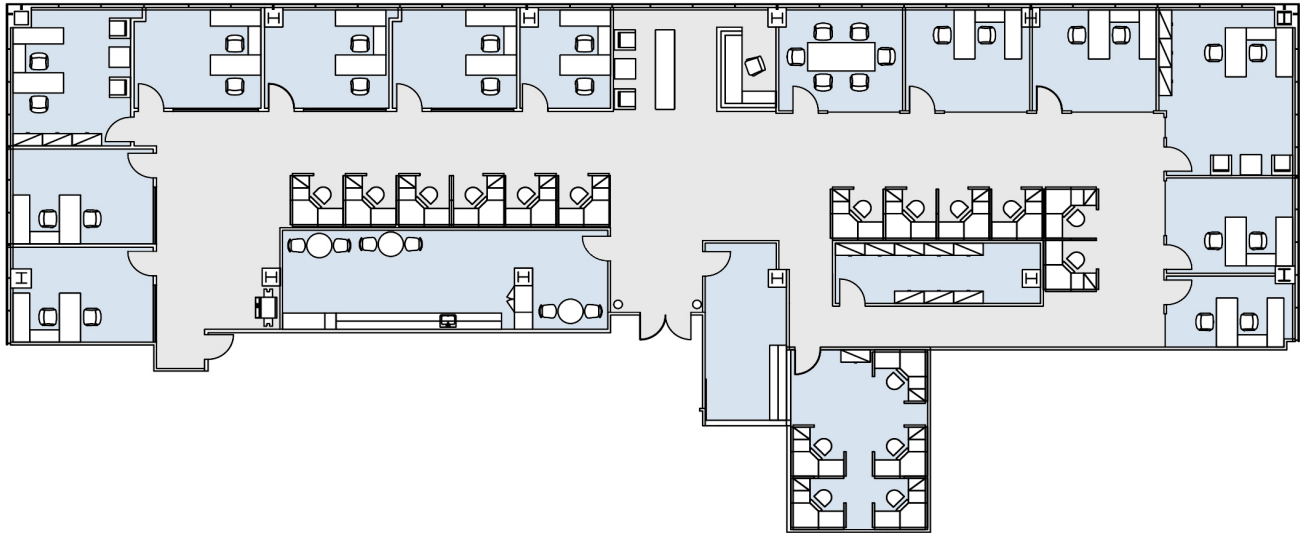

#### AS-BUILT CONFIGURATION

OFFICES:	12
CONFERENCE ROOM:	1
RECEPTION AREA:	1
STORAGE ROOM:	1
I.T. ROOM:	1
KITCHEN:	1

ADJUSTED FOR SOCIAL DISTANCING  
NOT TO SCALE  
FURNITURE NOT INCLUDED

For more information, please contact:

310.255.7777

leasing@douglasemmett.com

**Douglas  
Emmett**