

11845

OLYMPIC

SAWTELLE/WEST LA

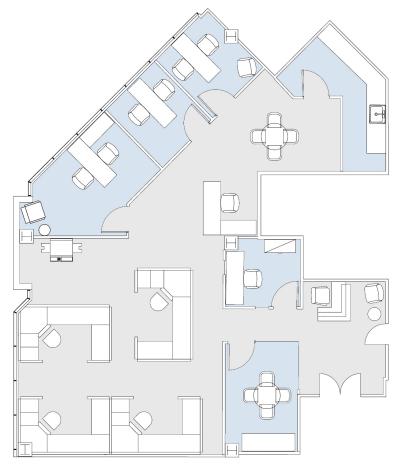

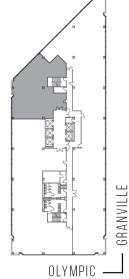

AS-BUILT CONFIGURATION

OFFICES:	4
CONFERENCE ROOM:	1
RECEPTION:	1
KITCHEN:	1
OPEN OFFICE:	1

ADJUSTED FOR SOCIAL DISTANCING NOT TO SCALE FURNITURE NOT INCLUDED

For more information, please contact:

