



11980

BRENTWOOD MEDICAL PLAZA

SUITE 106 | 9,170 RSF

BRENTWOOD-SAN VICENTE

SAN VICENTE

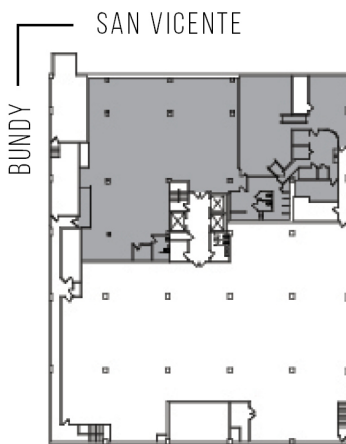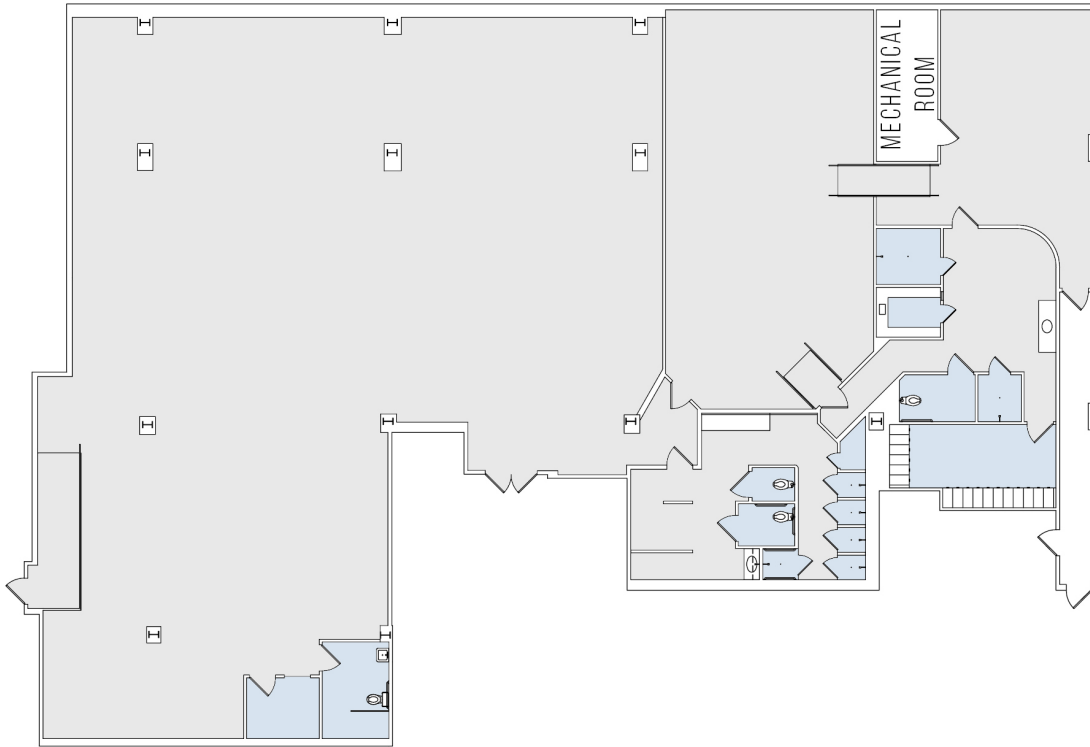

AS-BUILT CONFIGURATION

OFFICES:	1
RECEPTION:	1
STORAGE ROOM:	1
STORAGE CLOSET:	1
SAUNA:	1
RESTROOMS:	4
SHOWERS:	7
LOCKER ROOMS:	2

ADJUSTED FOR SOCIAL DISTANCING
NOT TO SCALE
FURNITURE NOT INCLUDED

For more information, please contact:

310.255.7777

leasing@douglasemmett.com

**Douglas
Emmett**