
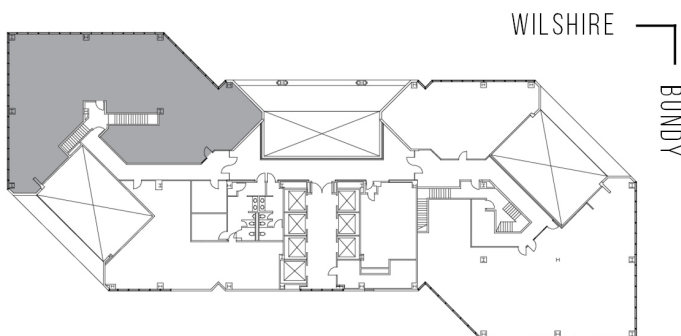


12100 WILSHIRE

SUITE M70 | 4,653 RSF
BRENTWOOD-WILSHIRE

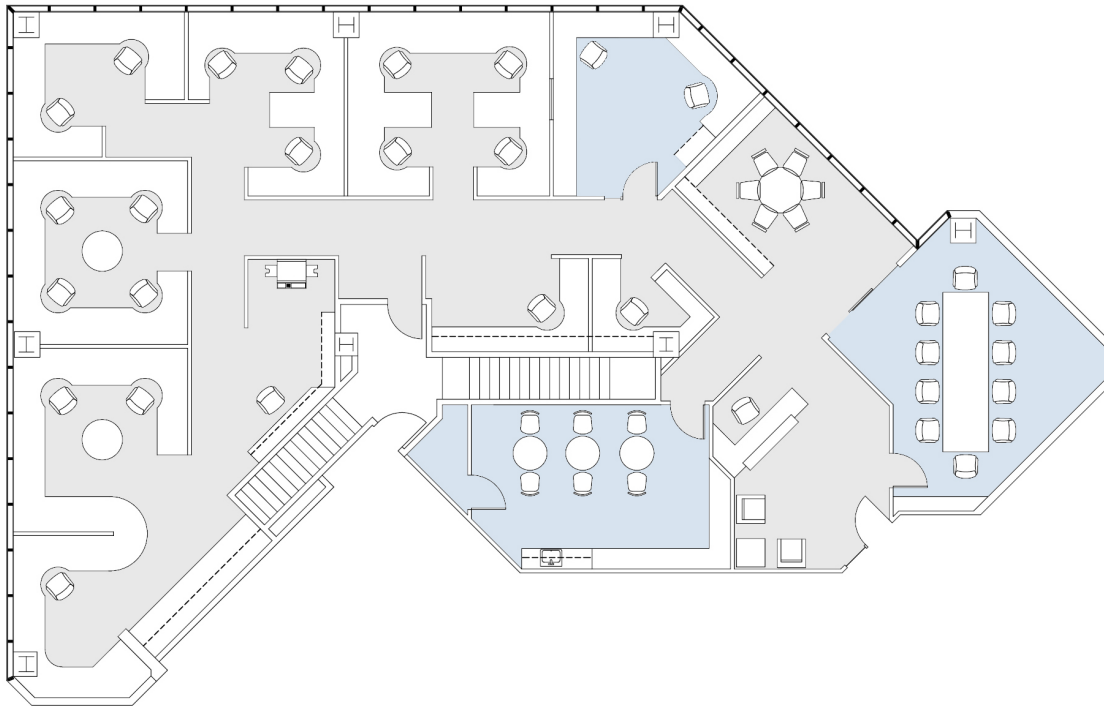

AS-BUILT CONFIGURATION

OFFICES:	1
CONFERENCE ROOM:	1
RECEPTION:	1
I.T. CLOSET:	1
LIBRARY:	1
STORAGE ROOM:	1
OPEN OFFICE:	7

ADJUSTED FOR SOCIAL DISTANCING
NOT TO SCALE
FURNITURE NOT INCLUDED

For more information, please contact:

310.255.7777
leasing@douglasemmett.com

**Douglas
Emmett**