
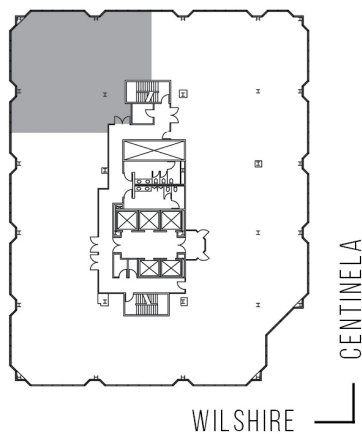


# 12424 WILSHIRE

GATEWAY LOS ANGELES

SUITE 840 | 2,994 RSF

BRENTWOOD-WILSHIRE

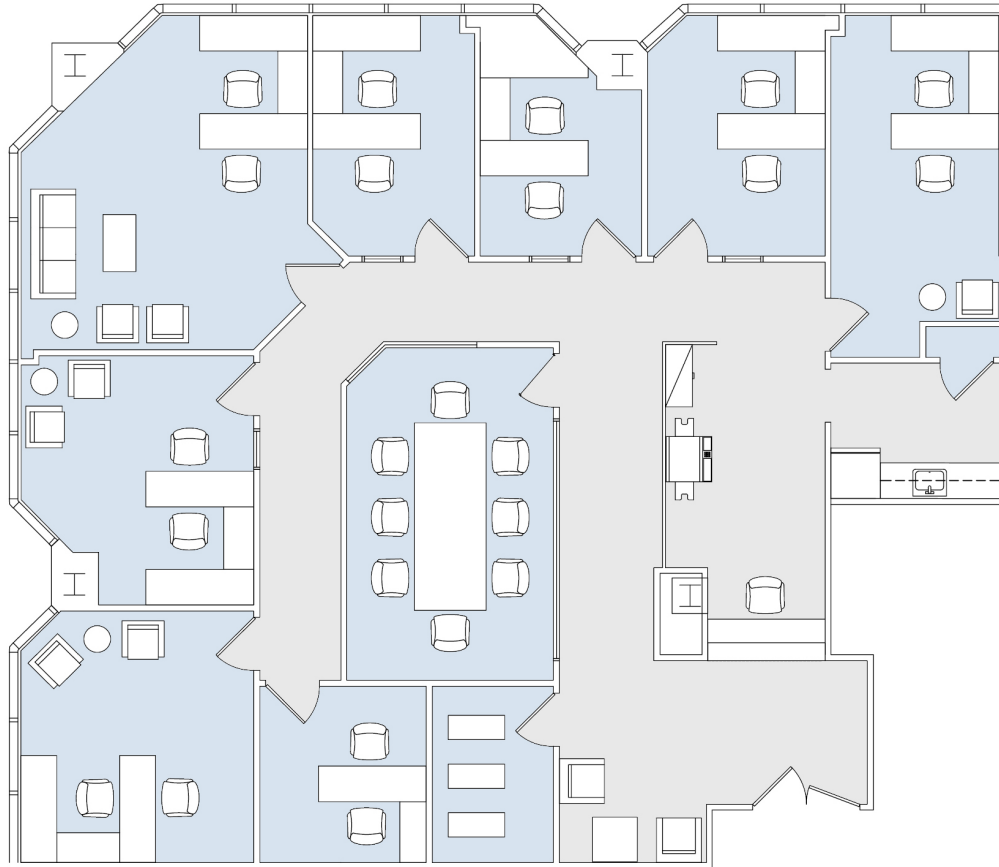

#### AS-BUILT CONFIGURATION

OFFICES:	8
CONFERENCE ROOM:	1
RECEPTION AREA:	1
STORAGE CLOSET:	1
KITCHEN:	1
I.T. ROOM:	1

ADJUSTED FOR SOCIAL DISTANCING  
NOT TO SCALE  
FURNITURE NOT INCLUDED

For more information, please contact:

310.255.7777

leasing@douglasemmett.com

**Douglas  
Emmett**