



11835

WESTSIDE TOWERS EAST TOWER

SUITE 1115 | 3,360 RSF

SAWTELLE/WEST LA

OLYMPIC

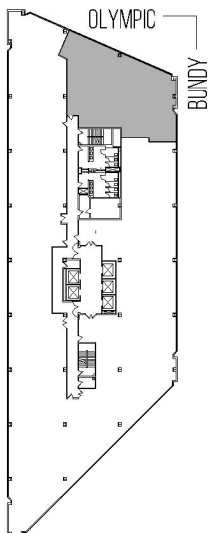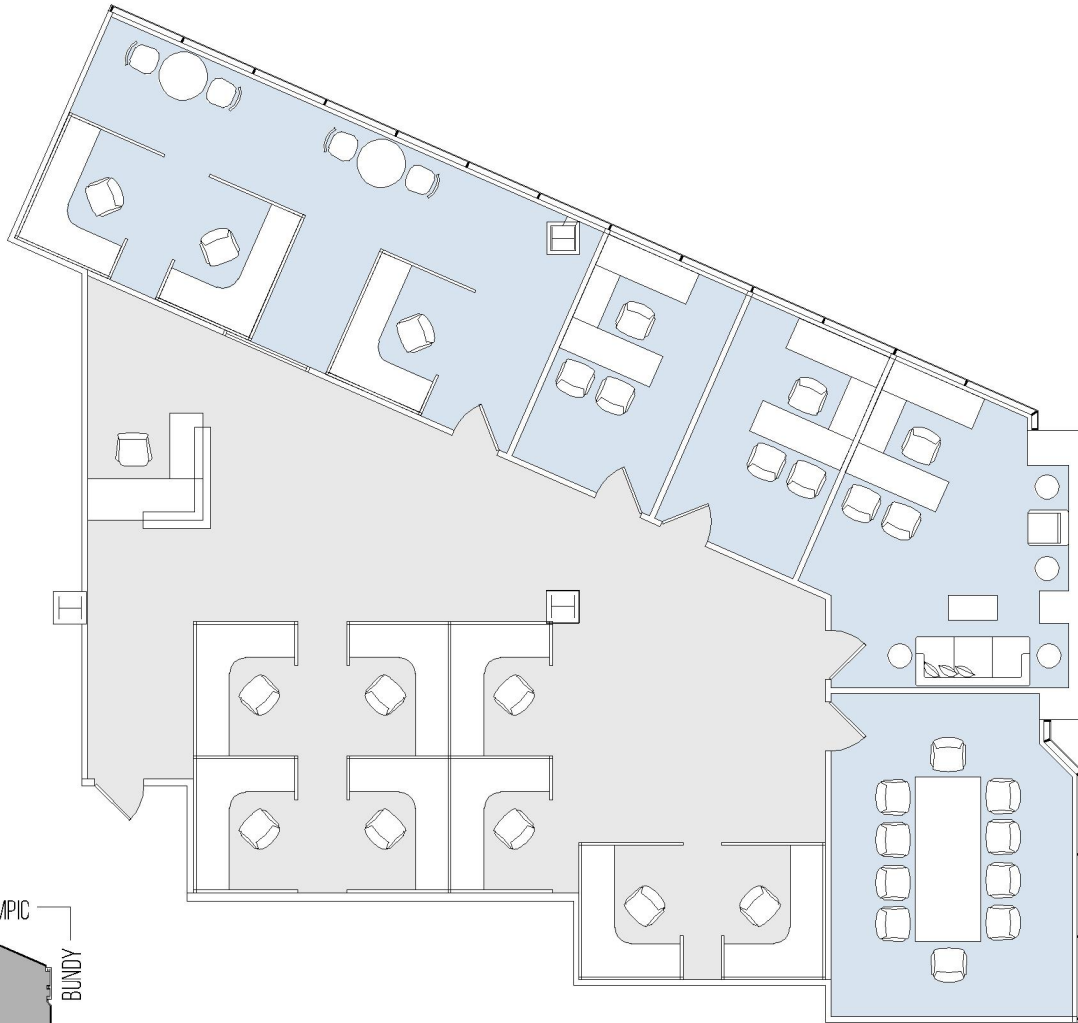

AS-BUILT CONFIGURATION

OFFICES:	4
CONFERENCE ROOM:	1
RECEPTION:	1

NOT TO SCALE
FURNITURE NOT INCLUDED

For more information, please contact:

310.255.7777
leasing@douglasemmett.com

**Douglas
Emmett**