
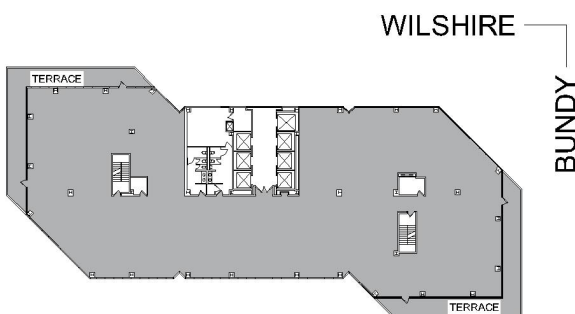


12100 WILSHIRE

SUITE 1800 | 17,636 RSF
BRENTWOOD-WILSHIRE

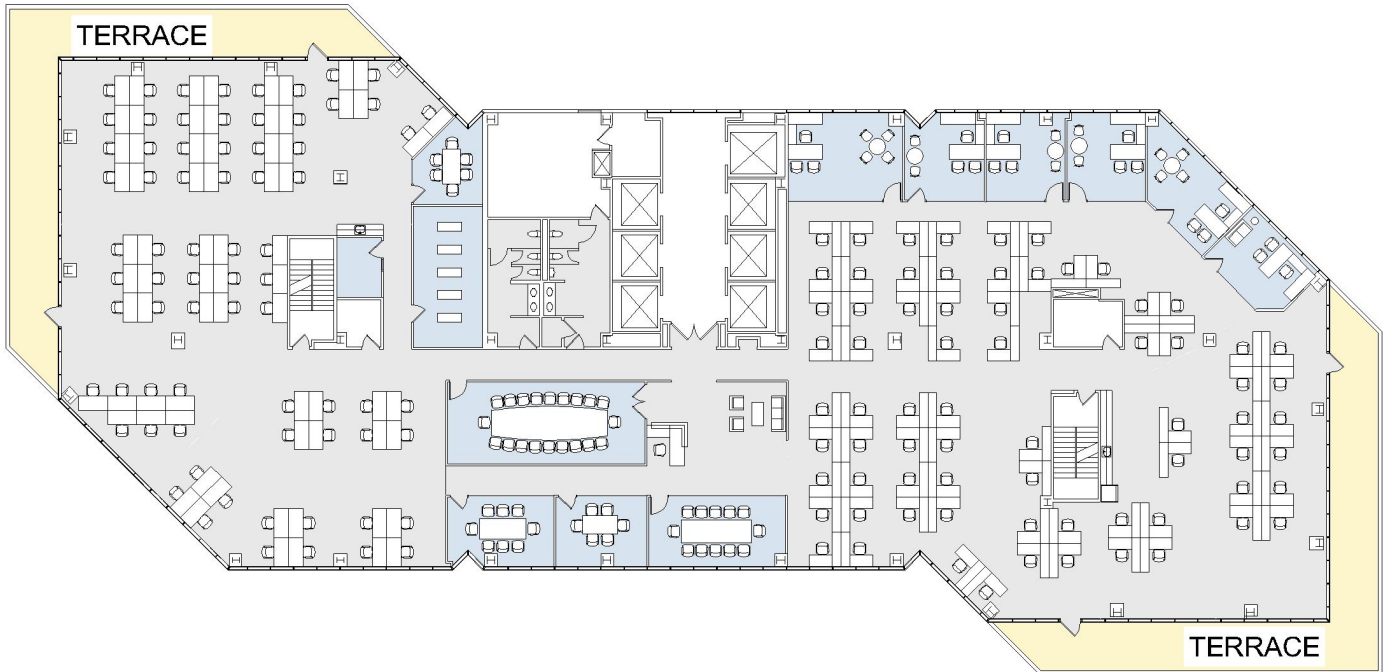

AS-BUILT CONFIGURATION

OFFICES:	6
CONFERENCE ROOM:	5
RECEPTION:	1
KITCHEN:	2
IT ROOM:	1
STORAGE:	2
RESTROOMS:	2

NOT TO SCALE
FURNITURE NOT INCLUDED

For more information, please contact:

310.255.7777
leasing@douglasemmett.com

**Douglas
Emmett**