


# 11726

BRENTWOOD EXECUTIVE PLAZA

SUITE 350 | 4,216 RSF

BRENTWOOD-SAN VICENTE

## SAN VICENTE

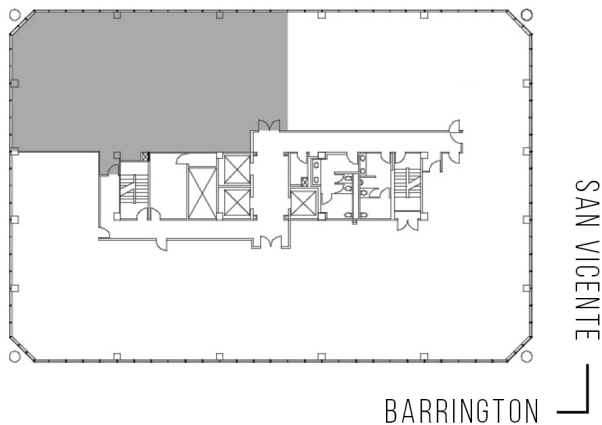

### AS-BUILT CONFIGURATION

OFFICES:	7
CONFERENCE ROOMS:	2
RECEPTION:	1
I.T. ROOM:	1
STORAGE ROOM:	1

ADJUSTED FOR SOCIAL DISTANCING  
NOT TO SCALE  
FURNITURE NOT INCLUDED

For more information, please contact:

310.255.7777

leasing@douglasemmett.com

**Douglas  
Emmett**