
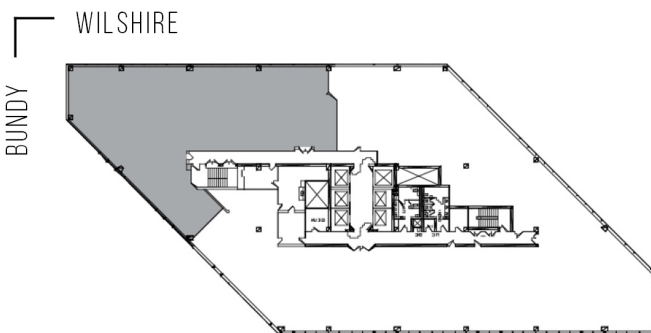


12121 WILSHIRE

WILSHIRE BUNDY PLAZA

SUITE 1325 | 6,352 RSF

BRENTWOOD-WILSHIRE

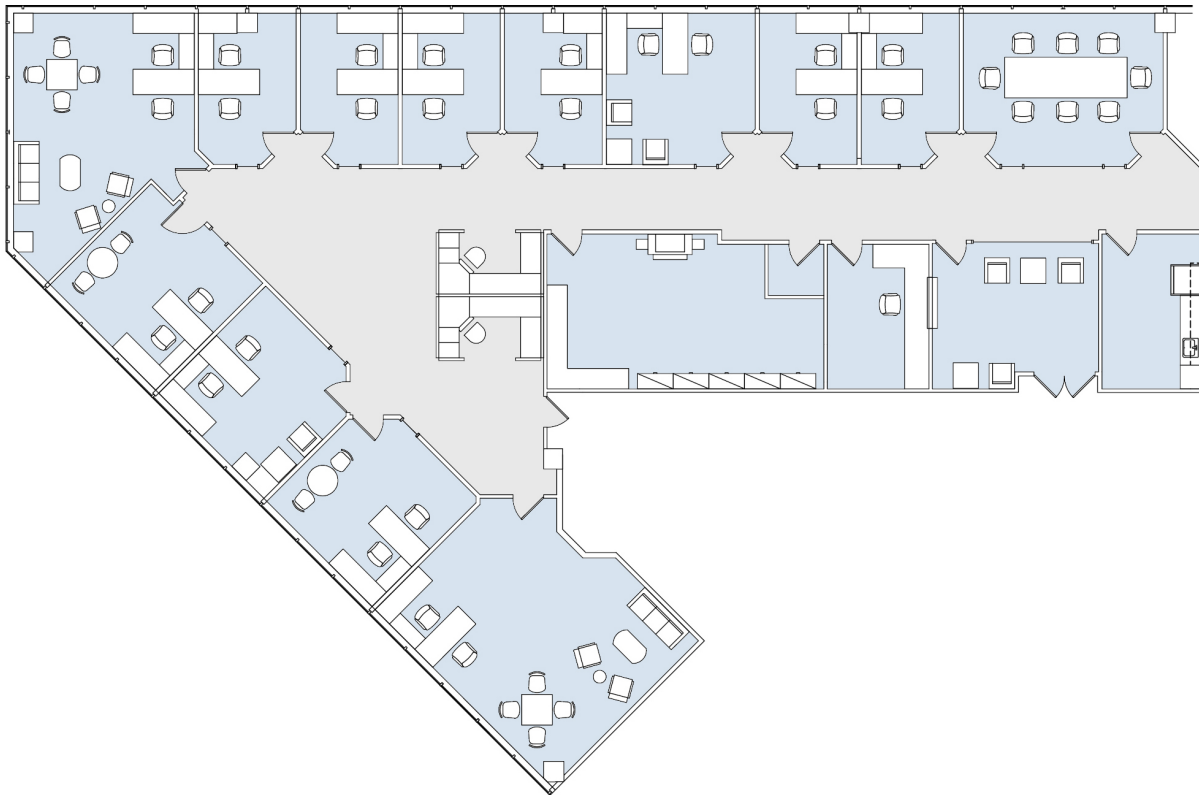

AS-BUILT CONFIGURATION

OFFICES:	12
CONFERENCE ROOM:	1
RECEPTION:	1
KITCHEN:	1
STORAGE CLOSET:	1
FILE/ COPY ROOM:	1

ADJUSTED FOR SOCIAL DISTANCING
NOT TO SCALE
FURNITURE NOT INCLUDED

For more information, please contact:

310.255.7777
leasing@douglasemmett.com

**Douglas
Emmett**