


11766 WILSHIRE

LANDMARK II

SUITE 400 | 5,156 RSF

BRENTWOOD-WILSHIRE

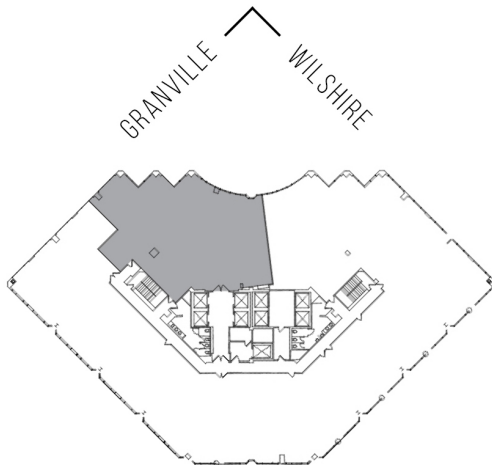

AS-BUILT CONFIGURATION

OFFICES:	6
CONFERENCE ROOM:	1
RECEPTION:	1
KITCHEN:	1
FILE/ STORAGE ROOM:	1

ADJUSTED FOR SOCIAL DISTANCING
NOT TO SCALE
FURNITURE NOT INCLUDED

For more information, please contact:

310.255.7777
leasing@douglasemmett.com

**Douglas
Emmett**