



1001

BISHOP SQUARE - ASB TOWER

SUITE 800 | 17,106 RSF

HONOLULU

# BISHOP STREET

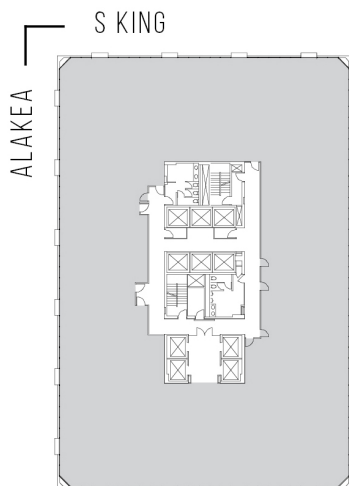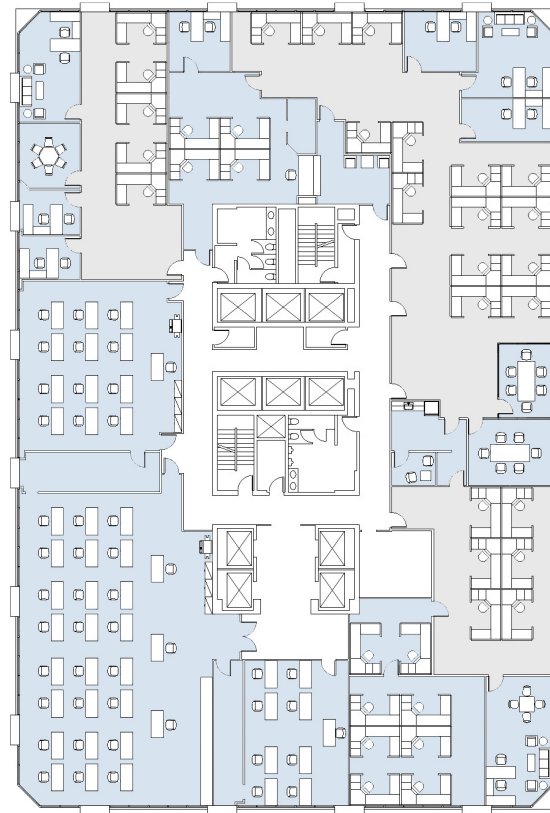

## AS-BUILT CONFIGURATION

OFFICES:	8
CONFERENCE ROOMS:	3
RECEPTION AREA:	1
KITCHEN:	1
STORAGE ROOMS:	3
OPEN OFFICE:	3
TRAINING ROOMS:	3

ADJUSTED FOR SOCIAL DISTANCING  
NOT TO SCALE  
FURNITURE NOT INCLUDED

For more information, please contact:

310.255.7777  
leasing@douglasemmett.com

**Douglas  
Emmett**