
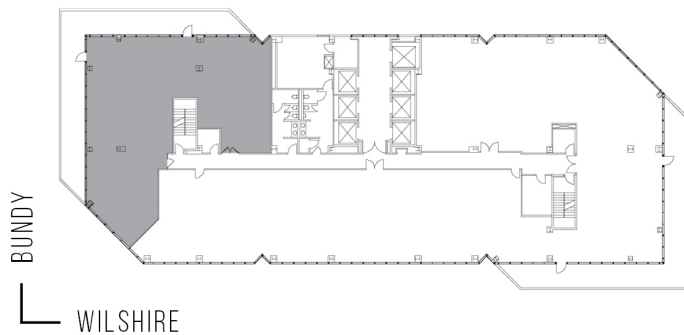


# 12100 WILSHIRE

SUITE 1940 | 3,879 RSF

BRENTWOOD-WILSHIRE

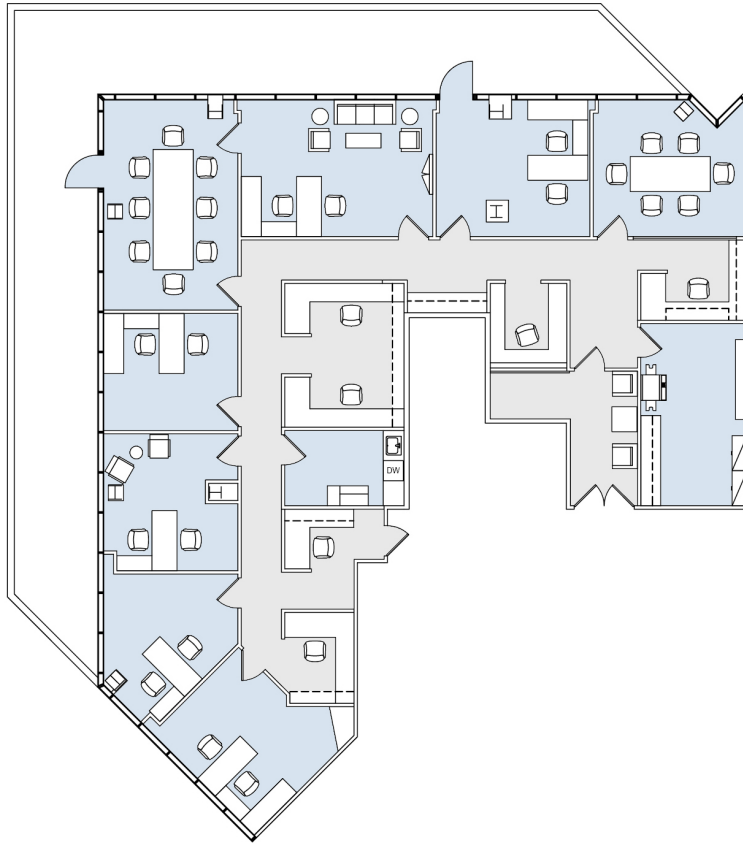

#### AS-BUILT CONFIGURATION

OFFICES:	6
CONFERENCE ROOMS:	2
RECEPTION:	1
KITCHEN:	1
STORAGE ROOM:	1

ADJUSTED FOR SOCIAL DISTANCING  
NOT TO SCALE  
FURNITURE NOT INCLUDED

For more information, please contact:

310.255.7777  
leasing@douglasemmett.com

**Douglas  
Emmett**