



# 55

HARBOR COURT - OFFICE

SUITE 2010 | 2,039 RSF

HONOLULU

## MERCHANT STREET

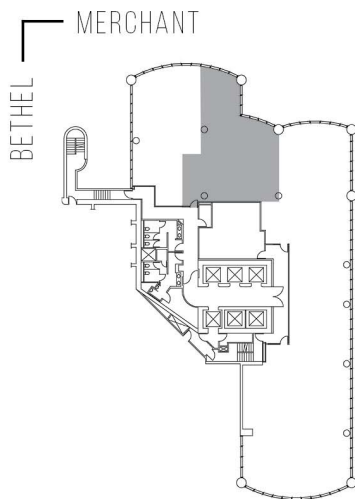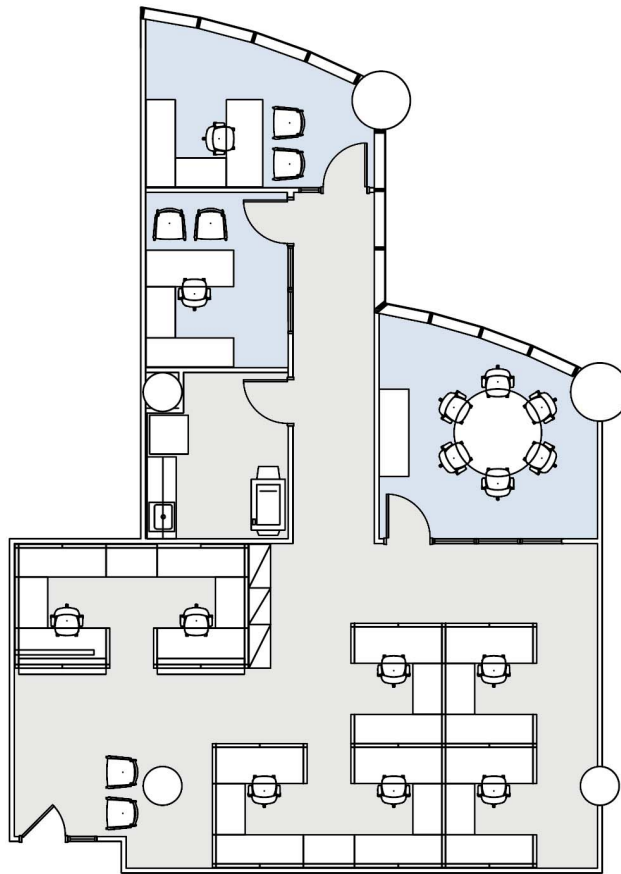

### AS-BUILT CONFIGURATION

OFFICES:	2
CONFERENCE ROOM:	1
RECEPTION:	1
KITCHEN:	1

NOT TO SCALE  
FURNITURE NOT INCLUDED

For more information, please contact:

310.255.7777

leasing@douglasemmett.com

**Douglas  
Emmett**