
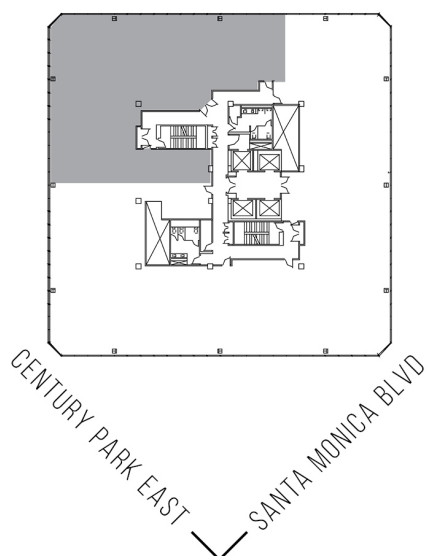


# 1801 CENTURY PARK EAST

CENTURY PARK PLAZA

SUITE 1910 | 5,171 RSF

CENTURY CITY

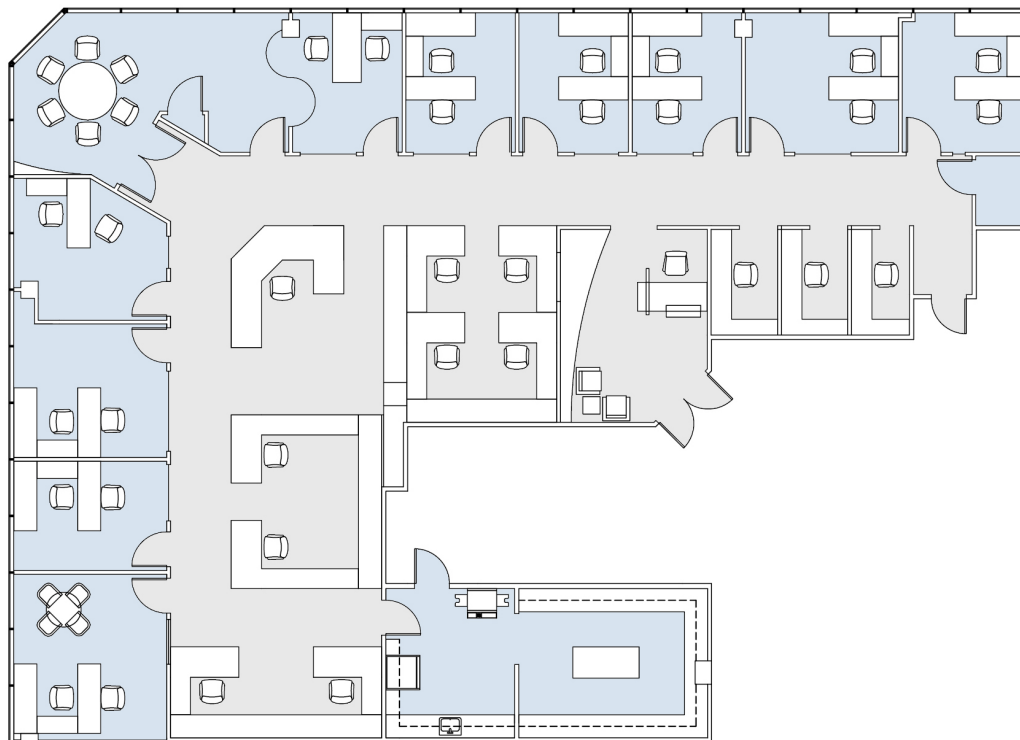

## AS-BUILT CONFIGURATION

OFFICES:	10
CONFERENCE ROOM:	1
RECEPTION AREA:	1
KITCHEN:	1
STORAGE CLOSET:	1
COPY/ FILE ROOM:	1
PHONE/ I.T. CLOSET:	1

ADJUSTED FOR SOCIAL DISTANCING  
NOT TO SCALE  
FURNITURE NOT INCLUDED

For more information, please contact:

310.255.7777

leasing@douglasemmett.com

**Douglas  
Emmett**