
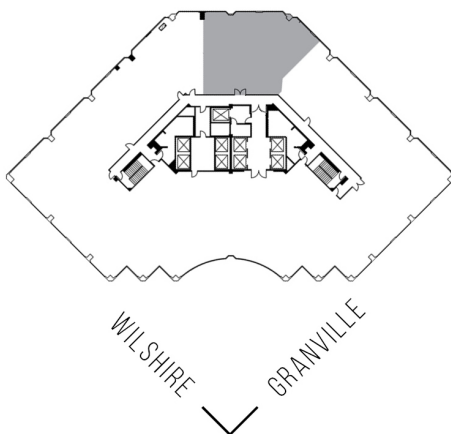


# 11766 WILSHIRE

LANDMARK II

SUITE 445 | 2,868 RSF

BRENTWOOD-WILSHIRE

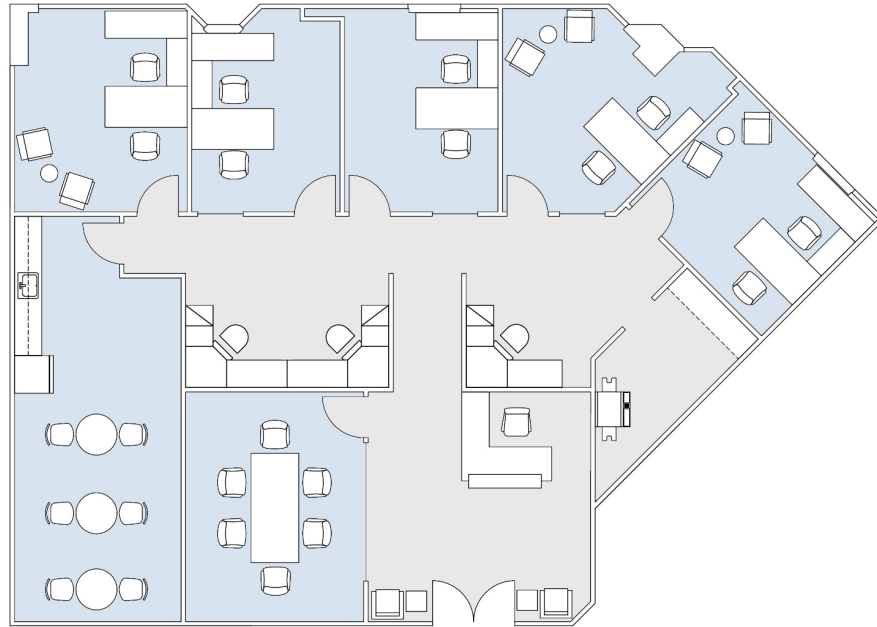

#### AS-BUILT CONFIGURATION

OFFICES:	5
CONFERENCE ROOM:	1
RECEPTION:	1
KITCHEN:	1
COPY/ STORAGE ROOM:	1

ADJUSTED FOR SOCIAL DISTANCING  
NOT TO SCALE  
FURNITURE NOT INCLUDED

For more information, please contact:

310.255.7777  
leasing@douglasemmett.com

**Douglas  
Emmett**