
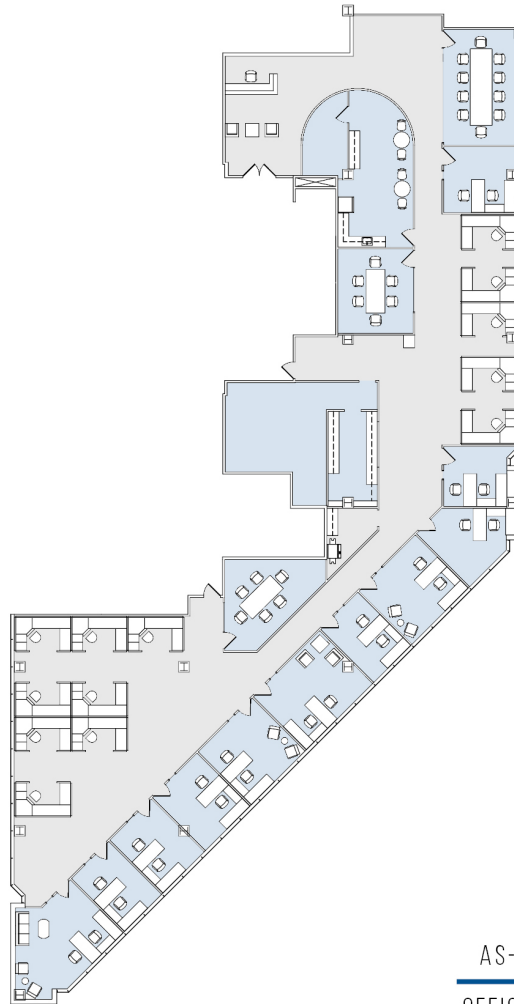


# 11845 OLYMPIC

WESTSIDE TOWERS WEST TOWER

SUITE 900 | 9,440 RSF

SAWTELLE/WEST LA

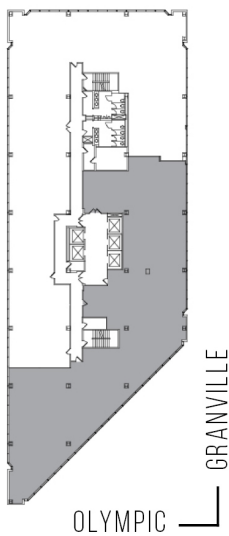

#### AS-BUILT CONFIGURATION

OFFICES:	11
CONFERENCE ROOMS:	3
RECEPTION:	1
KITCHEN:	1
STORAGE ROOM:	1
I.T. ROOM:	1
FILE ROOM:	1
OPEN OFFICE:	2

ADJUSTED FOR SOCIAL DISTANCING  
NOT TO SCALE  
FURNITURE NOT INCLUDED

For more information, please contact:

310.255.7777  
leasing@douglasemmett.com

**Douglas  
Emmett**