


# 1901 AVENUE OF THE STARS

SUITE 950 | 16,240 RSF

CENTURY CITY

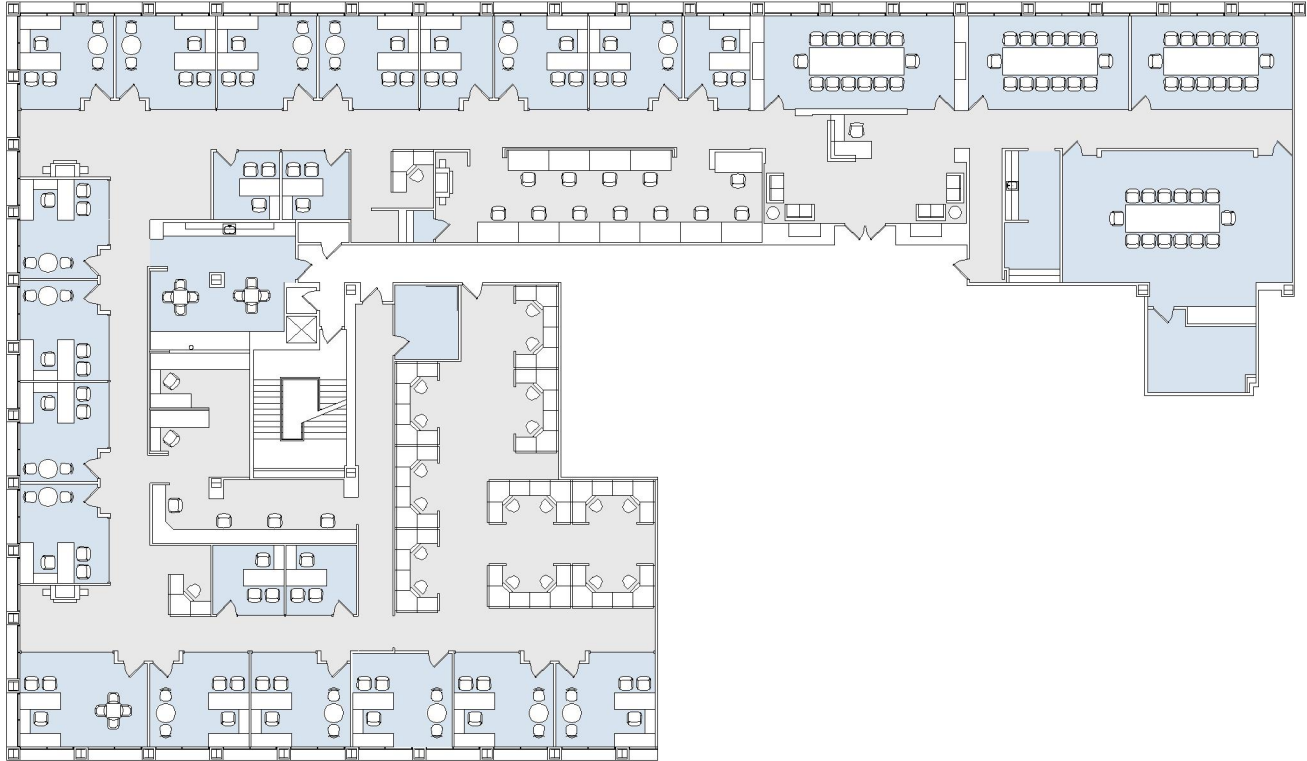


#### AS-BUILT CONFIGURATION

|                  |    |
|------------------|----|
| OFFICES:         | 22 |
| CONFERENCE ROOM: | 4  |
| RECEPTION:       | 1  |
| KITCHEN:         | 1  |
| STORAGE ROOM:    | 1  |
| STORAGE CLOSET:  | 1  |
| IT ROOM:         | 1  |

NOT TO SCALE

FURNITURE NOT INCLUDED

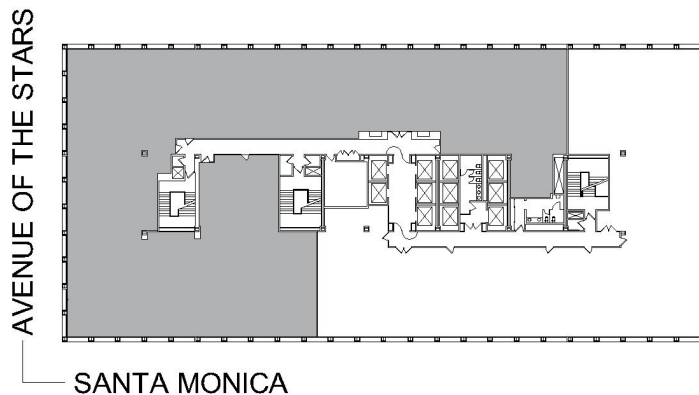

For more information, please contact:

310.255.7777

leasing@douglasemmett.com

**Douglas  
Emmett**