
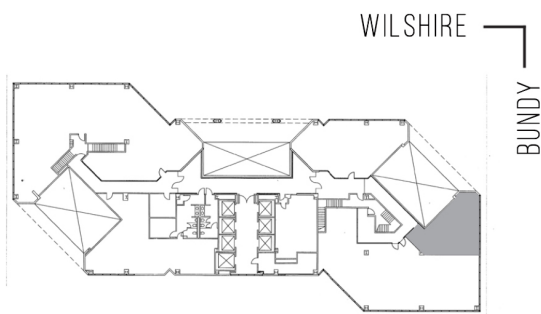


12100 WILSHIRE

SUITE M40 | 1,135 RSF

BRENTWOOD-WILSHIRE

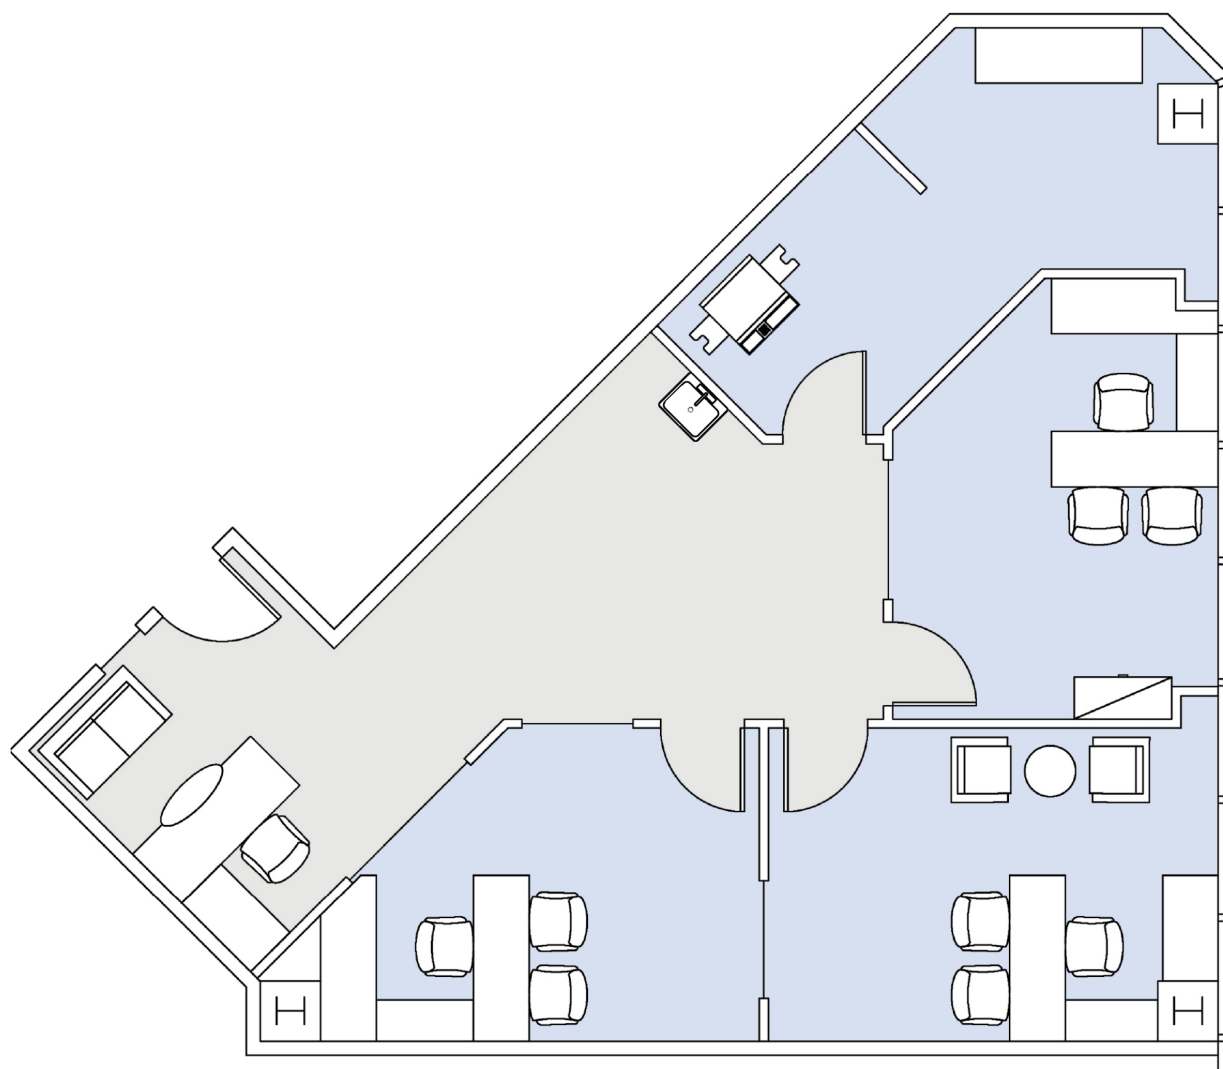

AS-BUILT CONFIGURATION

| | |
|------------|---|
| OFFICES: | 3 |
| STORAGE: | 1 |
| RECEPTION: | 1 |

NOT TO SCALE
FURNITURE NOT INCLUDED

For more information, please contact:

310.255.7777
leasing@douglasemmett.com

**Douglas
Emmett**