
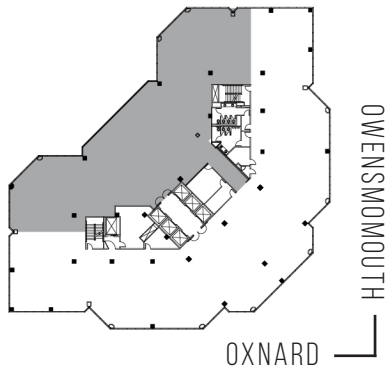


21650  
OXNARD

WARNER CENTER TOWER 3

SUITE 2450 | 11,792 RSF  
WOODLAND HILLS

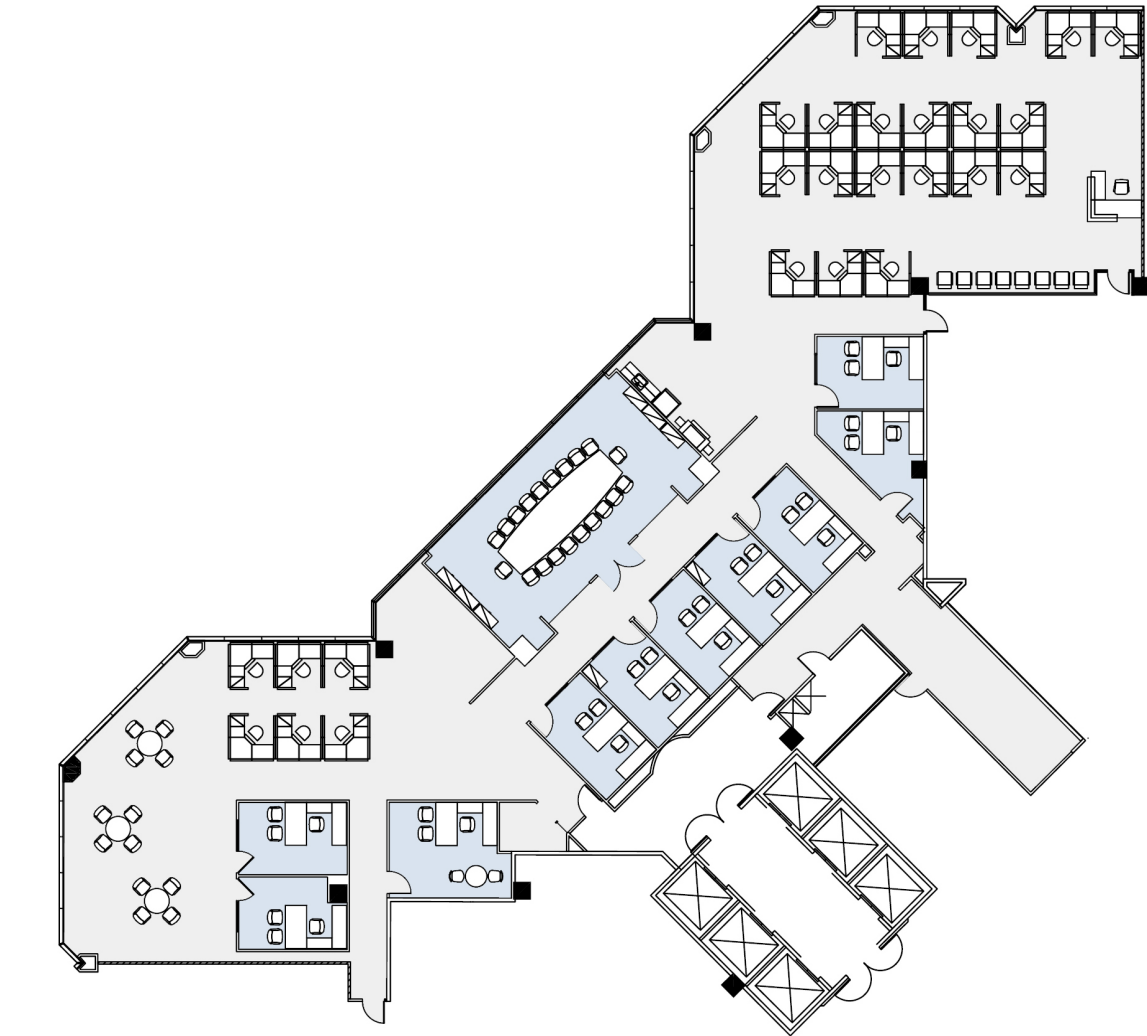

AS-BUILT CONFIGURATION

OFFICES:	10
CONFERENCE ROOM:	1
RECEPTION:	1
KITCHEN:	1
SERVER ROOM:	1

NOT TO SCALE  
FURNITURE NOT INCLUDED

For more information, please contact:

JIM LINDVALL  
818.531.9678  
jim.lindvall@am.jll.com

HAYLEY BLOCKLEY  
213.239.6054  
hayley.blockley@am.jll.com

