


# 10940 WILSHIRE

THE TOWER

SUITE 150 | 2,113 RSF

WESTWOOD

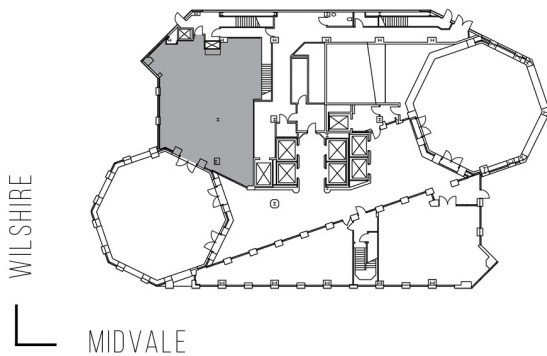

#### AS-BUILT CONFIGURATION

OFFICES:	2
CONFERENCE ROOM:	1
KITCHEN:	1
RECEPTION:	1
IT CLOSET:	1

NOT TO SCALE  
FURNITURE NOT INCLUDED

For more information, please contact:

310.255.7777

leasing@douglasemmett.com

**Douglas  
Emmett**