
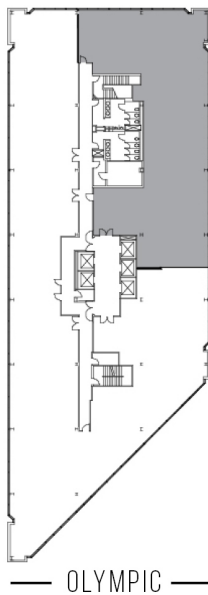


11845 OLYMPIC

WESTSIDE TOWERS WEST TOWER

SUITE 600 | 6,364 RSF

SAWTELLE/WEST LA

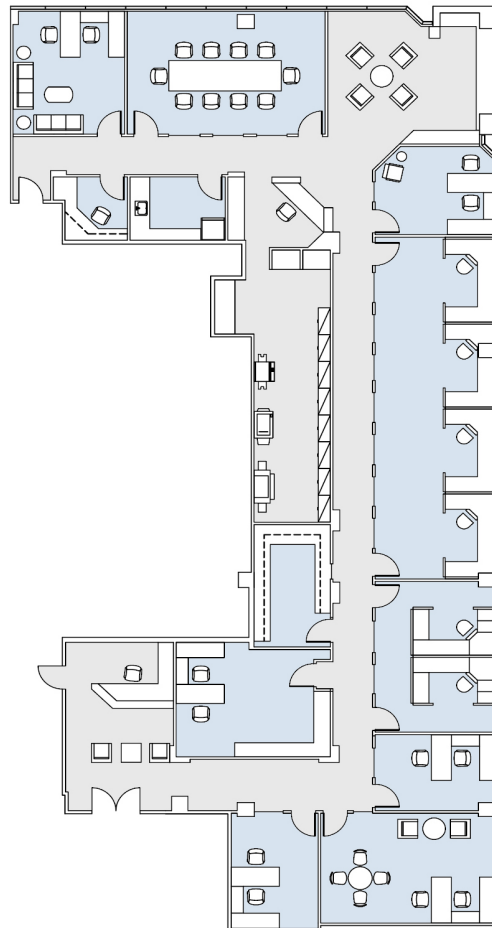

AS-BUILT CONFIGURATION

OFFICES:	7
CONFERENCE ROOM:	1
RECEPTION:	1
FILE/ COPY ROOM:	1
KITCHEN:	1
OPEN OFFICE:	3

ADJUSTED FOR SOCIAL DISTANCING

NOT TO SCALE
FURNITURE NOT INCLUDED

For more information, please contact:

310.255.7777

leasing@douglasemmett.com

**Douglas
Emmett**