
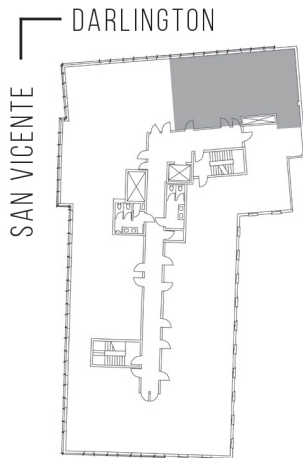


11633

BRENTWOOD SAN VICENTE MEDICAL SOUTH SUITE 302 | 1,344 RSF

BRENTWOOD-SAN VICENTE

SAN VICENTE

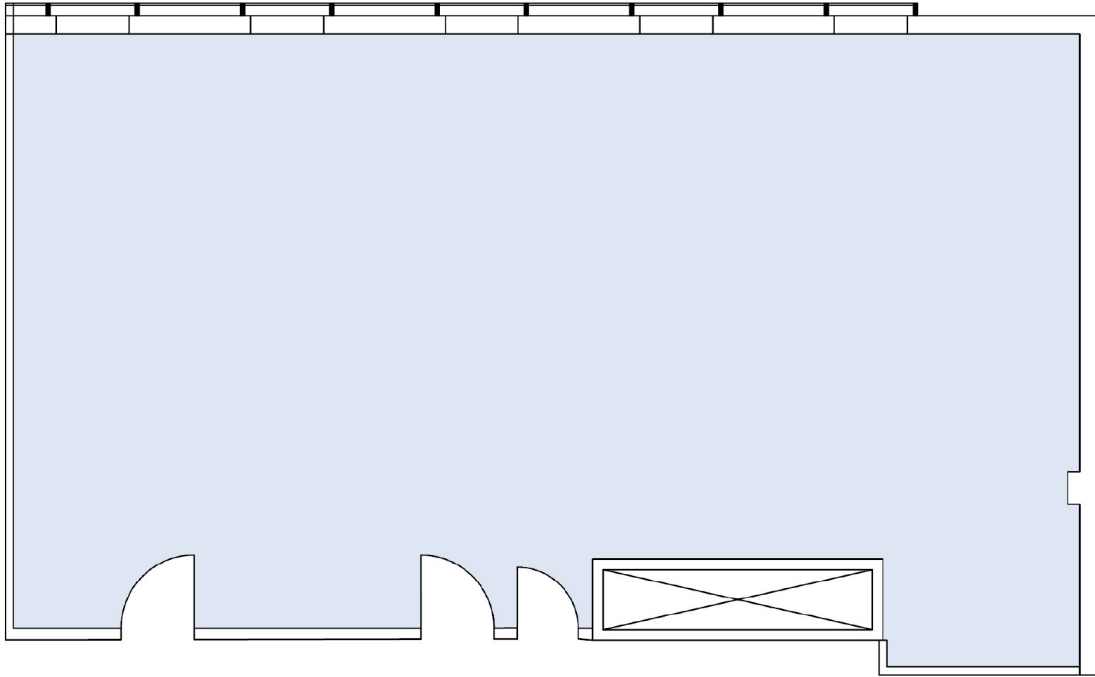

AS-BUILT CONFIGURATION

OPEN SPACE

NOT TO SCALE
FURNITURE NOT INCLUDED

For more information, please contact:

310.255.7777
leasing@douglasemmett.com

**Douglas
Emmett**