
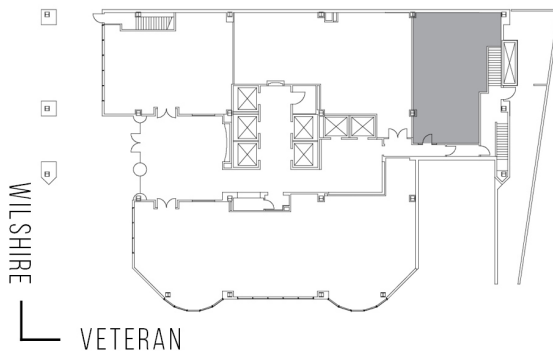


10990 WILSHIRE

ONE WESTWOOD

SUITE 180 | 1,210 RSF

WESTWOOD

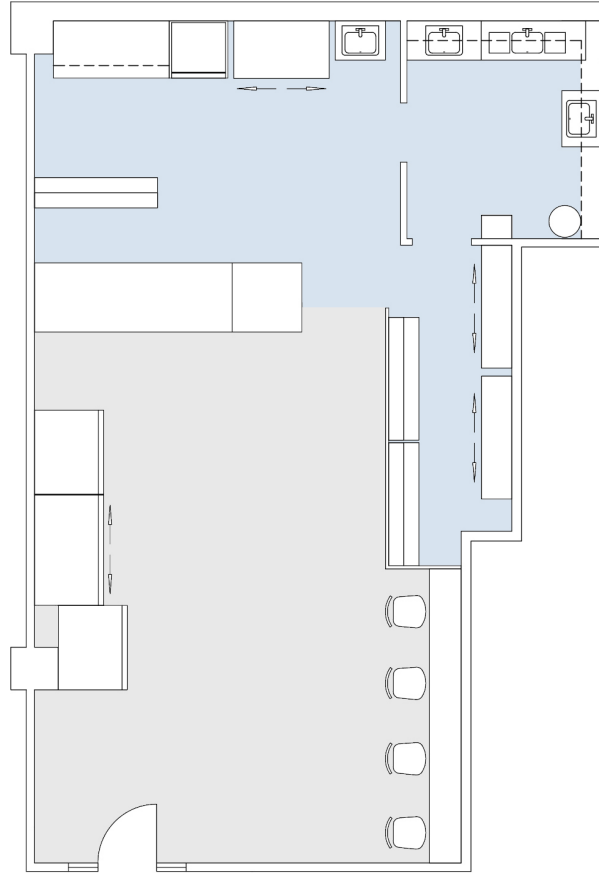

AS-BUILT CONFIGURATION

DINNING ROOM:	1
KITCHEN:	1
PREP AREA:	1

ADJUSTED FOR SOCIAL DISTANCING
NOT TO SCALE
FURNITURE NOT INCLUDED

For more information, please contact:

310.255.7777

leasing@douglasemmett.com

**Douglas
Emmett**