


11845 OLYMPIC

WESTSIDE TOWERS WEST TOWER

SUITE 1250 | 4,305 RSF

SAWTELLE/WEST LA

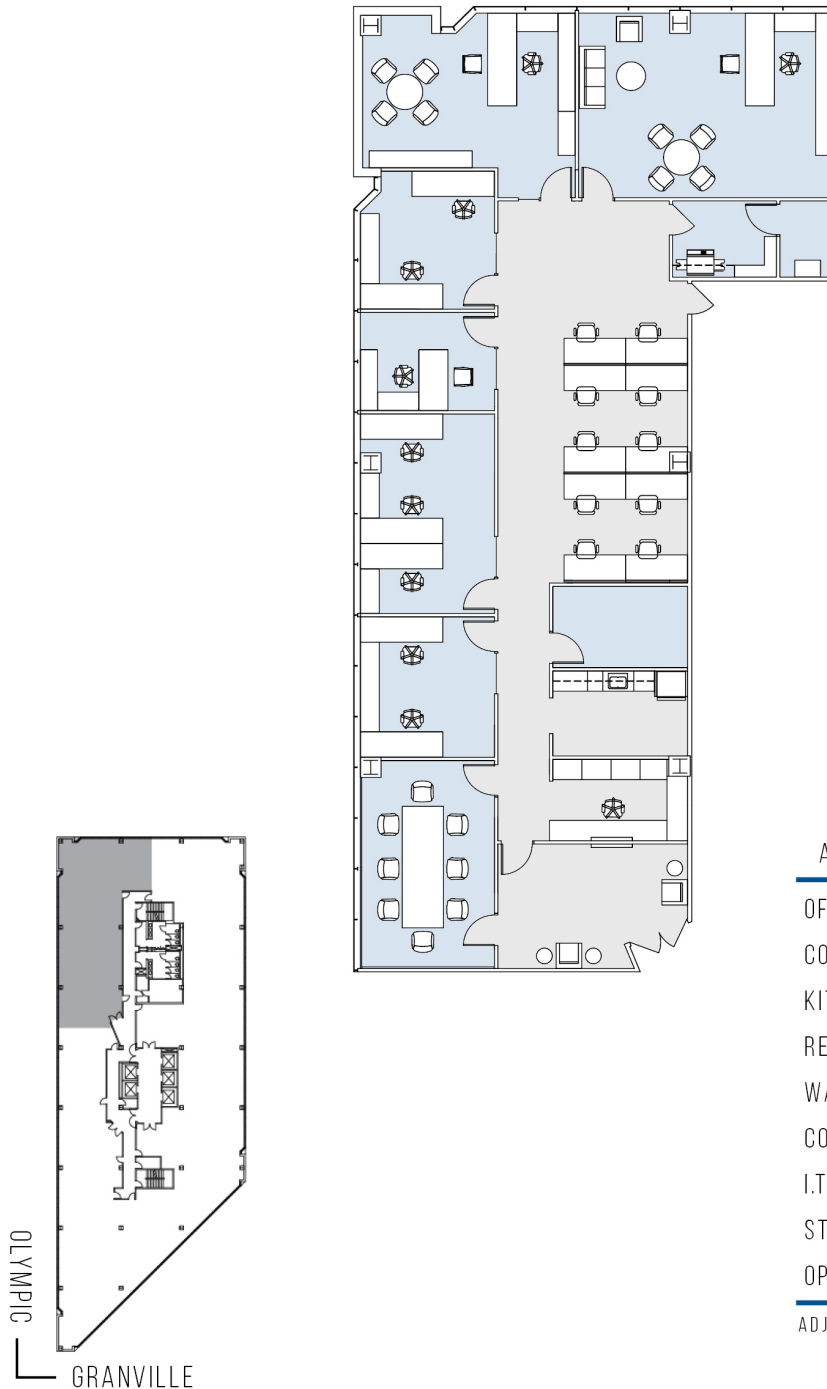

AS-BUILT CONFIGURATION

OFFICES:	6
CONFERENCE ROOM:	1
KITCHEN:	1
RECEPTION:	1
WAITING ROOM:	1
COPY ROOM:	1
I.T. CLOSET:	1
STORAGE ROOM:	1
OPEN OFFICE:	1

ADJUSTED FOR SOCIAL DISTANCING
NOT TO SCALE
FURNITURE NOT INCLUDED

For more information, please contact:

310.255.7777

leasing@douglasemmett.com

**Douglas
Emmett**