



21550

WARNER CENTER TOWER - II

SUITE 125 | 6,256 RSF

WOODLAND HILLS

OXNARD STREET

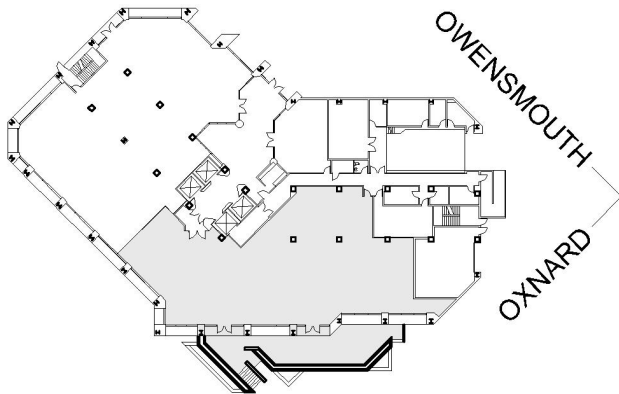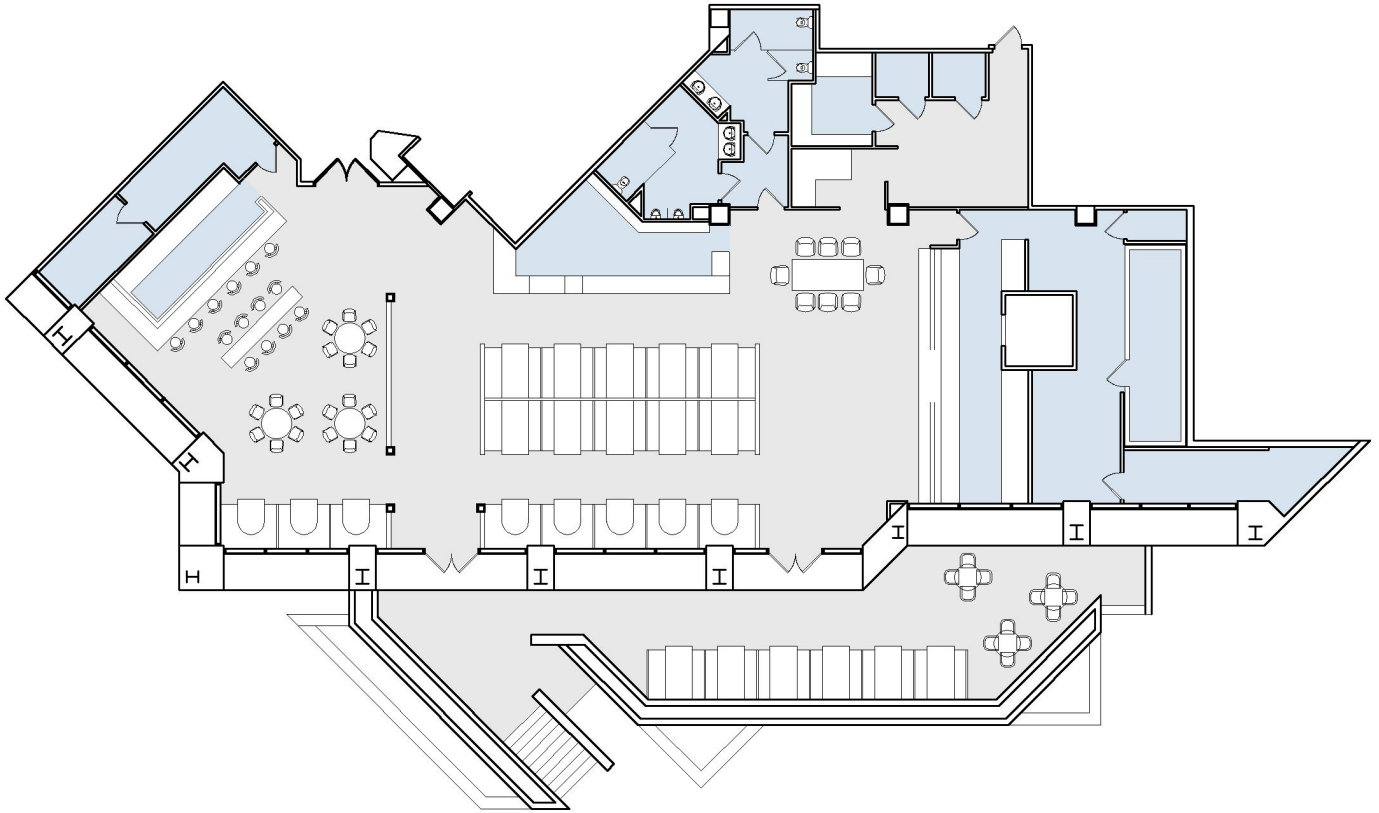

AS-BUILT CONFIGURATION

OPEN KITCHEN:	1
FOOD STORAGE:	8
BAR:	1
DISPLAY CASE:	1
PRIVATE PATIO:	1
PRIVATE RESTROOMS:	2

NOT TO SCALE
FURNITURE NOT INCLUDED

For more information, please contact:

310.255.7777
leasing@douglasemmett.com

