
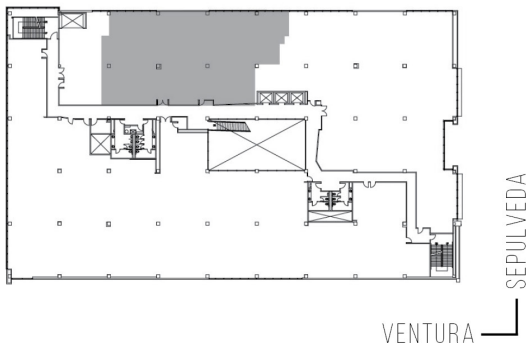


# 15301 VENTURA

SOG-ATRIUM BUILDING

SUITE 150 | 7,565 RSF

SHERMAN OAKS/ENCINO

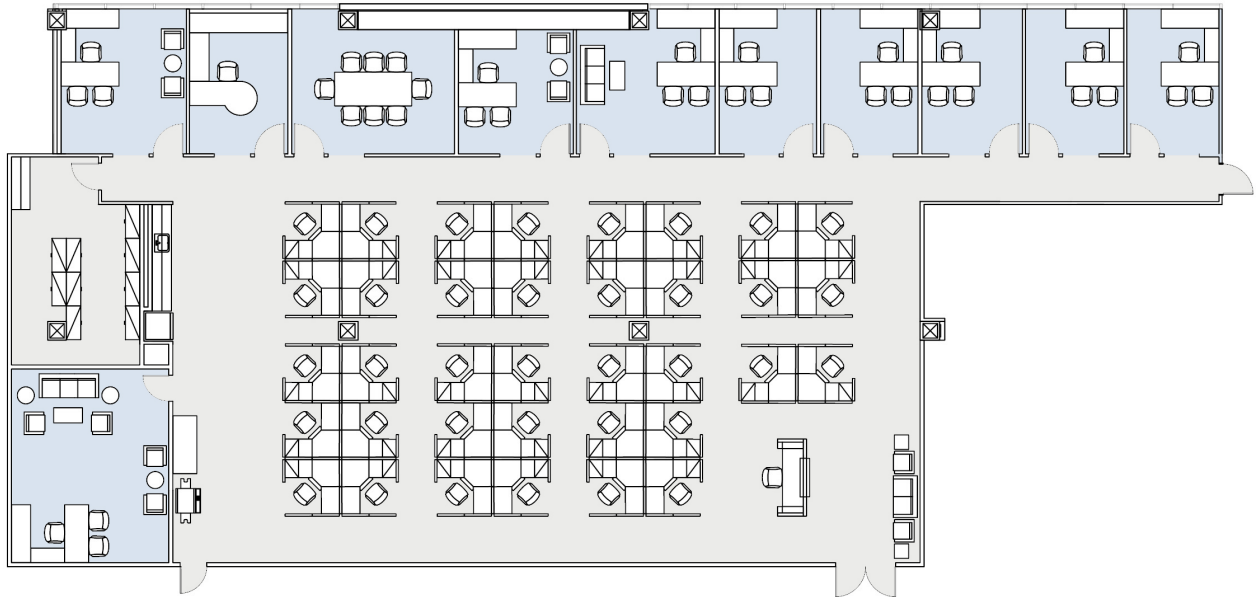

#### AS-BUILT CONFIGURATION

|                  |    |
|------------------|----|
| OFFICES:         | 10 |
| CONFERENCE ROOM: | 1  |
| RECEPTION:       | 1  |
| FILE/STORAGE:    | 1  |

NOT TO SCALE  
FURNITURE NOT INCLUDED

For more information, please contact:

310.255.7777  
leasing@douglasemmett.com

**Douglas  
Emmett**