
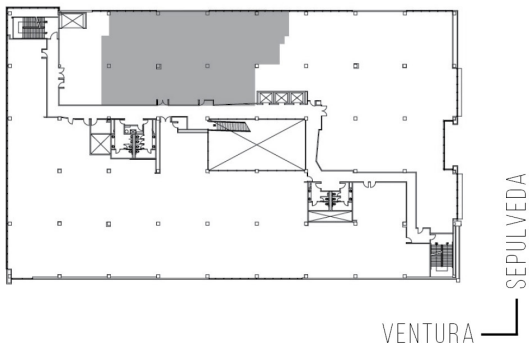


15301 VENTURA

SOG-ATRIUM BUILDING

SUITE 150 | 7,565 RSF

SHERMAN OAKS/ENCINO

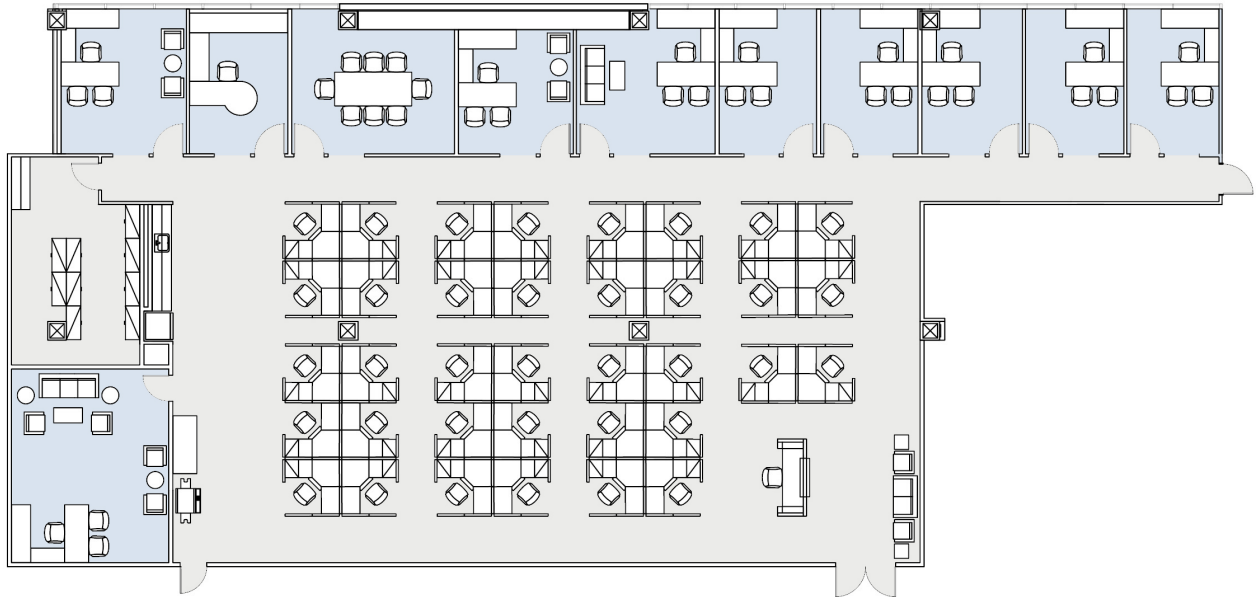

AS-BUILT CONFIGURATION

OFFICES:	10
CONFERENCE ROOM:	1
RECEPTION:	1
FILE/STORAGE:	1

NOT TO SCALE
FURNITURE NOT INCLUDED

For more information, please contact:

310.255.7777
leasing@douglasemmett.com

**Douglas
Emmett**