
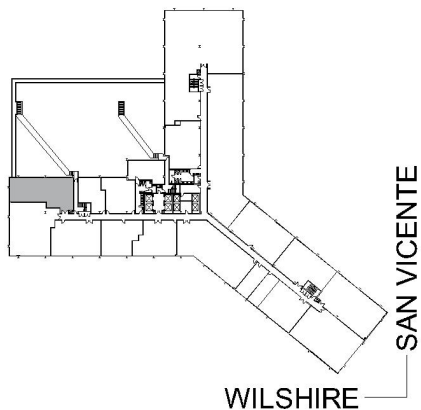


8383 WILSHIRE

SUITE 208 | 2,028 RSF

BEVERLY HILLS

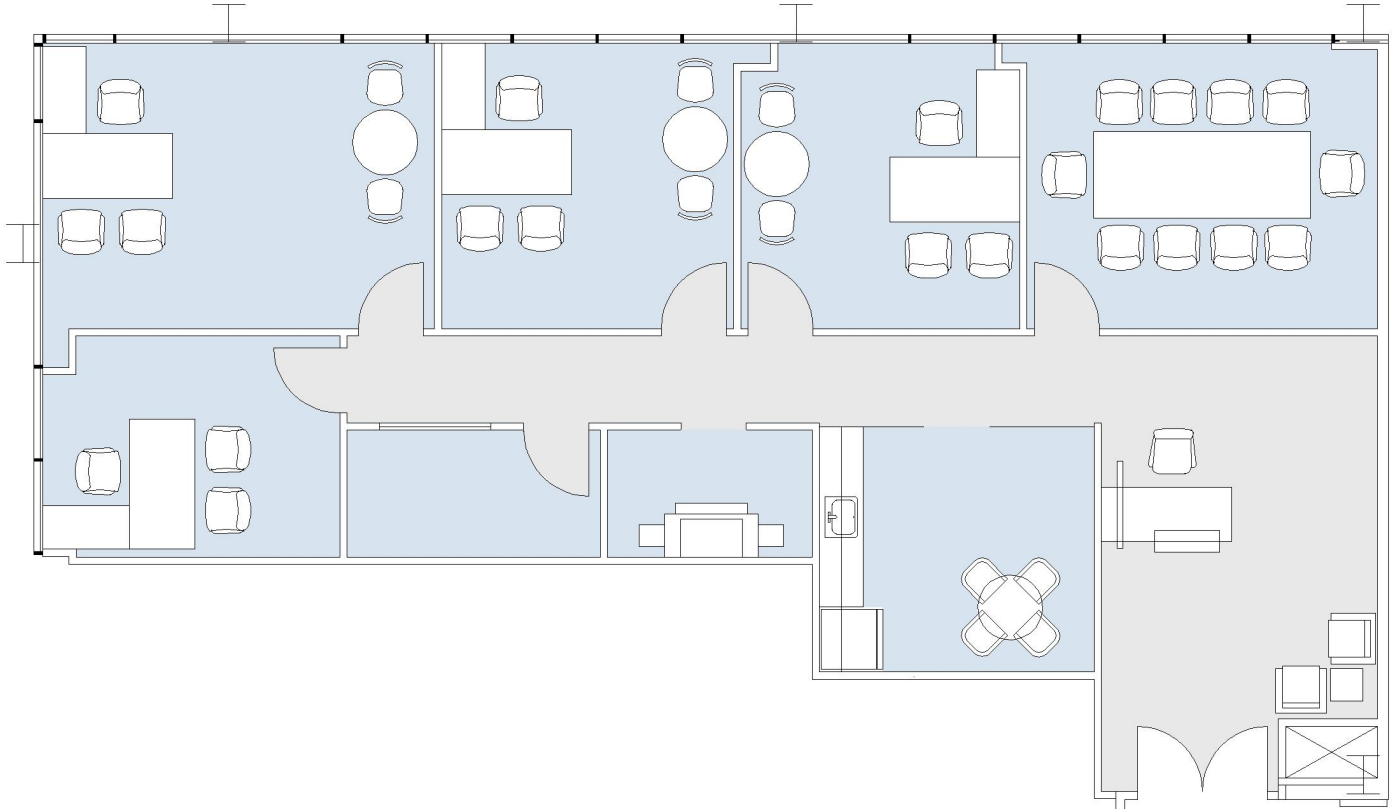

AS-BUILT CONFIGURATION

OFFICES:	4
CONFERENCE ROOM:	1
RECEPTION:	1
KITCHEN:	1
IT / COPY ROOM:	1
STORAGE ROOM:	1

NOT TO SCALE

FURNITURE NOT INCLUDED

For more information, please contact:

310.255.7777
leasing@douglasemmett.com

**Douglas
Emmett**