
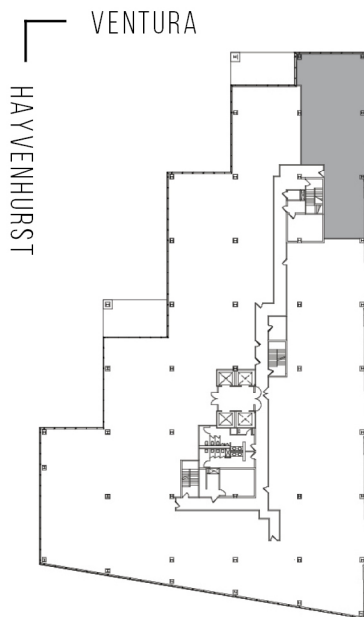


# 16501 VENTURA

SUITE 215 | 3,322 RSF  
SHERMAN OAKS/ENCINO

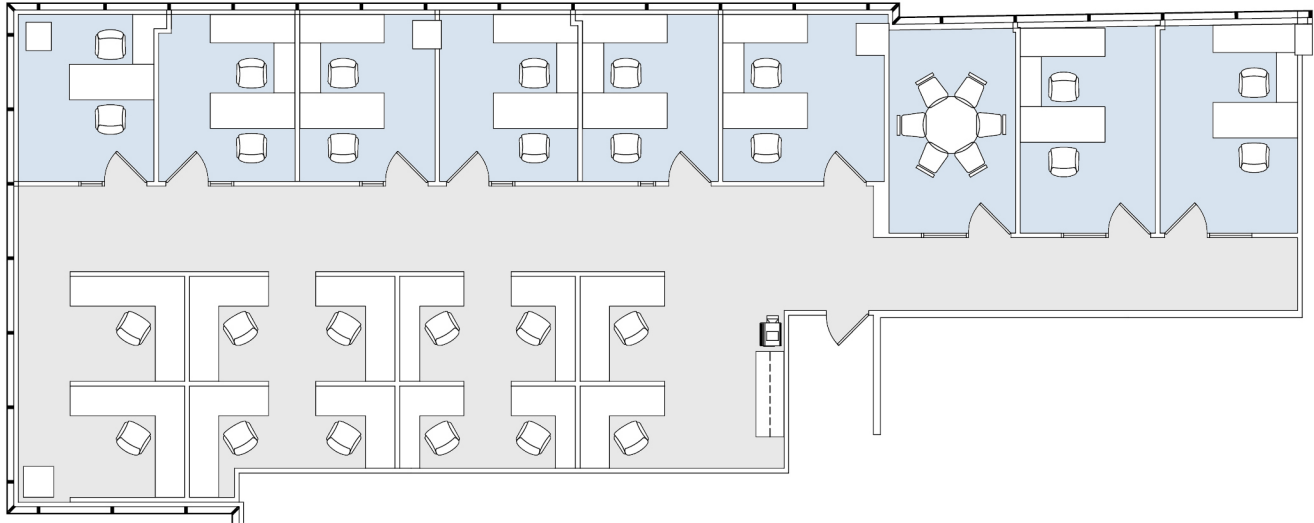

#### AS-BUILT CONFIGURATION

OFFICES:	8
CONFERENCE ROOM:	1
WORK STATIONS:	12

ADJUSTED FOR SOCIAL DISTANCING  
NOT TO SCALE  
FURNITURE NOT INCLUDED

For more information, please contact:

310.255.7777  
leasing@douglasemmett.com

**Douglas  
Emmett**