
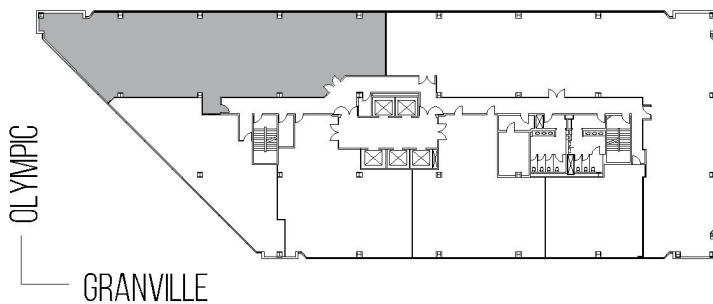


# 11845 OLYMPIC

WESTSIDE TOWERS WEST TOWER

SUITE 850 | 4,837 RSF

SAWTELLE/WEST LA

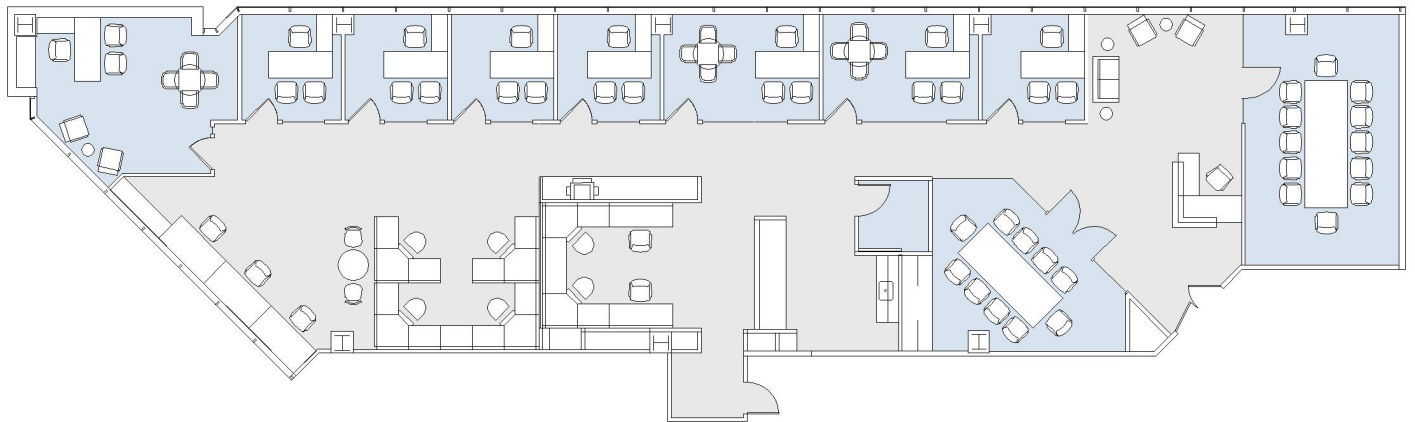

## AS-BUILT CONFIGURATION

OFFICES:	8
CONFERENCE ROOM:	2
RECEPTION:	1
KITCHEN:	1

NOT TO SCALE  
FURNITURE NOT INCLUDED

For more information, please contact:

310.255.7777

leasing@douglasemmett.com

**Douglas  
Emmett**