



15821

ENCINO TERRACE

SUITE 435 | 3,313 RSF

SHERMAN OAKS/ENCINO

VENTURA

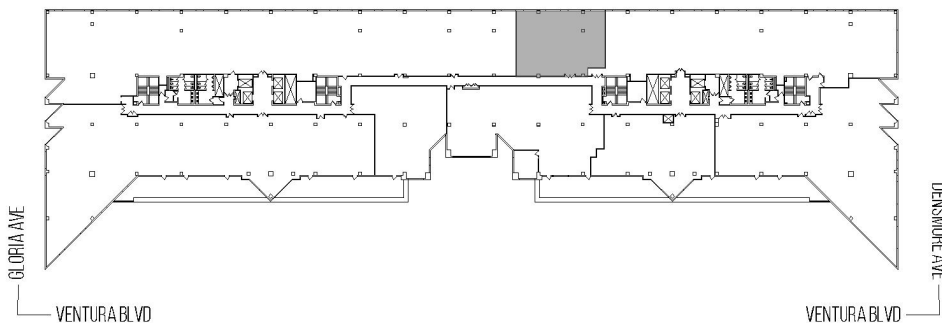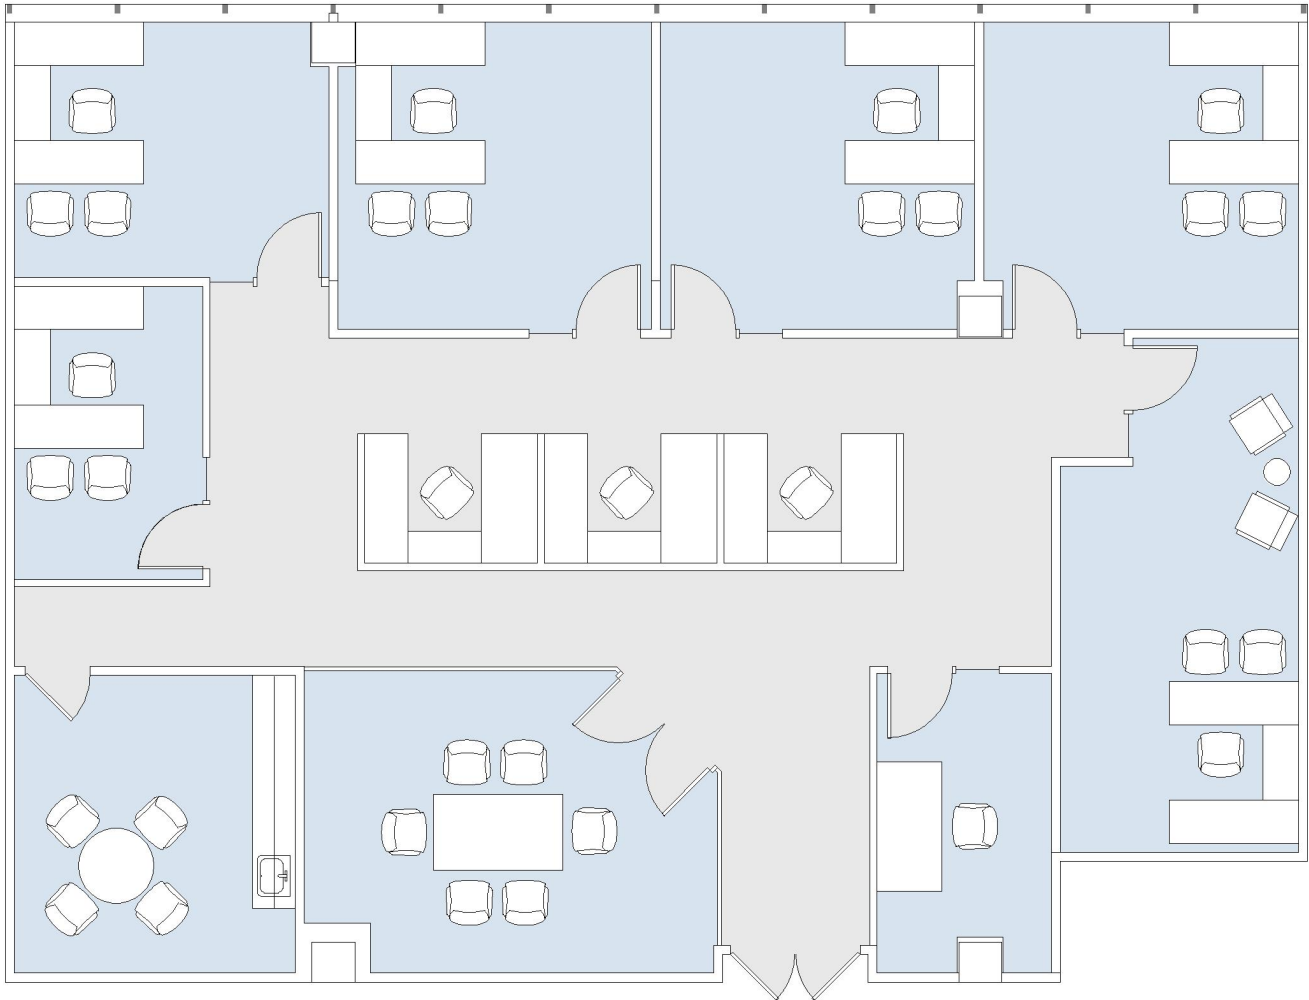

AS-BUILT CONFIGURATION

OFFICES:	7
CONFERENCE ROOM:	1
KITCHEN:	1

NOT TO SCALE
FURNITURE NOT INCLUDED

For more information, please contact:

310.255.7777
leasing@douglasemmett.com

**Douglas
Emmett**