
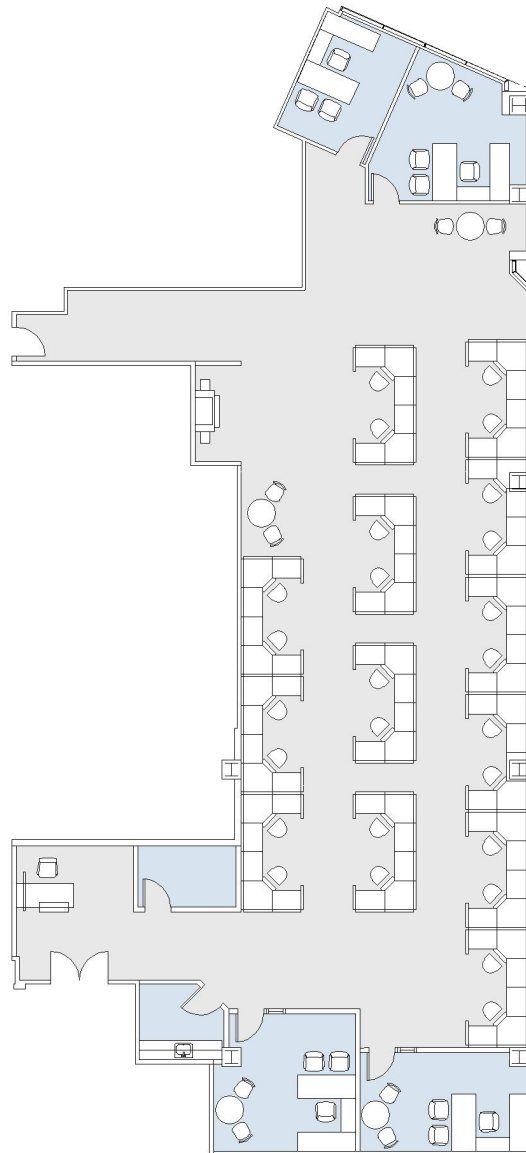


11835 OLYMPIC

WESTSIDE TOWERS EAST TOWER

SUITE 1250 | 5,022 RSF

SAWTELLE/WEST LA

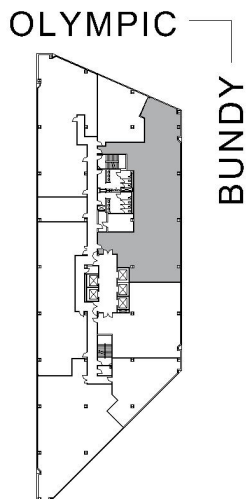

AS-BUILT CONFIGURATION

OFFICES:	4
RECEPTION:	1
KITCHEN:	1
STORAGE ROOM:	1

NOT TO SCALE

FURNITURE NOT INCLUDED

For more information, please contact:

310.255.7777

leasing@douglasemmett.com

**Douglas
Emmett**